

J55  
7-3-64

WATER WELL DRILLERS LOG **CODED**

Date: 7-3, 1964, Driller: Sutter Well Works County Harrison  
(Name)

(1) Owner of Land: Bureau Cuevas  
(Name)  
Box 1 - Pass Christian Miss.  
(Address)

(2) Location: NW 1/4, SE 1/4, Sec. 24 T 15R 13, W  
5 miles NE of De Lisle,  
(distance) (direction) (Nearest Town)

(3) Topography: Hilly  
(Hilly) (Flat) (Level)

(4) Purpose of Well: Domestic  
(Domestic Irrigation  
Municipal, Industrial, Other)

Description & Color of Materials Sand, Clay, Red Clay, Shell, etc.	Thick- ness Feet	Depth Feet
Clay	26	26
sand	30	56
Clay	29	85
sand	41	126
Clay	64	190
sand	15	205
Clay	123	328
fine sand	50	378
Clay	53	431
sand	34	465
Clay	25	490
sand	47	537

Information upon completion of well:

(1) Diameter 2 inches.

(2) Total Depth 537 feet.

(3) Water Level 42 feet below top of ground.

(4) Cased to cell, Size 2"

(5) Screen: Size 2", Length 10'


(6) Were any formations sealed against pollution?  
no.

**CODED**

If YES depth of formation \_\_\_\_\_

Why \_\_\_\_\_

Drillers Remarks: \_\_\_\_\_

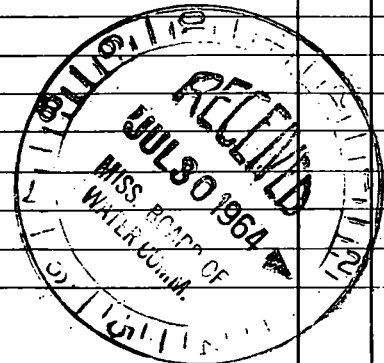

(Use Back Side)

Well No.

1919

Handwritten notes and a table with columns and rows of numbers.

Handwritten notes and a table with columns and rows of numbers.