

J56
7-7-64

WATER WELL DRILLERS LOG **CODED**

Date: 7-7, 1964, Driller: Little Well Works County Harrison
(Name)

- (1) Owner of Land: Chas. Klumpf
(Name)
Pear Christian, Miss.
(Address)
- (2) Location: NE 1/4, SE 1/4, Sec. 38 T7S R13 W
5 miles N, of Cuevas
(distance) (direction) (Nearest Town)
- (3) Topography: Hilly
(Hilly) (Flat) (Level)
- (4) Purpose of Well: domestic
(Domestic Irrigation
Municipal, Industrial, Other)


Description & Color of Materials Sand, Clay, Red Clay, Shell, etc.	Thick- ness Feet	Depth Feet
Clay	10	10
sand	85	95
Clay	78	173
sand	17	190
Clay	180	370
sand	37	407
Clay	28	435
sand	40	475
Clay	20	495
sand	61	556

Information upon completion of well:

- (1) Diameter 2 x 4 inches.
- (2) Total Depth 556 feet.
- (3) Water Level 19 feet below top of ground.
- (4) Cased to all, TOP 103'-4", Size BAL. 2"
- (5) Screen: Size 2", Length 10'
- (6) Were any formations sealed against pollution?
yes, no.

CODED

If YES depth of formation _____
Why _____
Drillers Remarks: _____

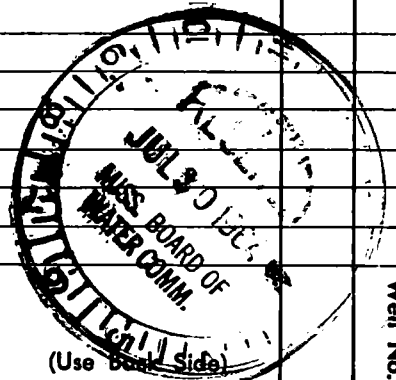

Well No. _____

(Use back side)

1941

Handwritten notes and lists, possibly a calendar or ledger, with various entries and numbers.

Main body of handwritten text, appearing to be a detailed record or account, with multiple lines of entries.