

J58

8-7-64

WATER WELL DRILLERS LOG

CODED

Date: 8-7, 1964, Driller: Better Well Works County Harrison
(Name)

- (1) Owner of Land: Elmer Ladner
(Name)
Rt 1 Pass Christian, Miss
(Address)
- (2) Location: NW 1/4, SE 1/4, Sec. 6 T7SR13, W
7 miles SW, of Pigeon,
(distance) (direction) (Nearest Town)
- (3) Topography: Hilly
(Hilly) (Flat) (Level)
- (4) Purpose of Well: Domestic
(Domestic Irrigation
Municipal, Industrial, Other)

Description & Color of Materials Sand, Clay, Red Clay, Shell, etc.	Thick- ness Feet	Depth Feet
<u>Clay</u>	<u>63</u>	<u>63</u>
<u>sand</u>	<u>102</u>	<u>165</u>
<u>Clay</u>	<u>131</u>	<u>296</u>
<u>sand</u>	<u>29</u>	<u>325</u>


CODED

Information upon completion of well:

- (1) Diameter 2 inches.
- (2) Total Depth 325 feet.
- (3) Water Level 48 feet below top of ground.
- (4) Cased to all, Size 2"
- (5) Screen: Size 2", Length 10'
- (6) Were any formations sealed against pollution?
 yes, no.

If YES depth of formation Surface
Why _____

Drillers Remarks: _____

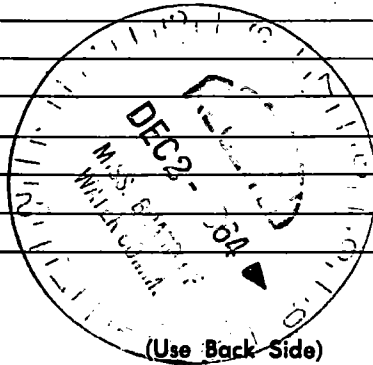

(Use Back Side)

Well No.

SECRET

... ..

... ..

