

J59
8-21-64

WATER WELL DRILLERS LOG

CODED

Date: 8-21, 1964, Driller: Jutton Well Works County Harrison
(Name)

(1) Owner of Land: Elroy Swilley
(Name)
Rt. 1 Pass Christian, Miss.
(Address)

(2) Location: SE 1/4, NW 1/4, Sec. 4 T. 75R. 13W
6 miles SW of Pigeon
(distance) (direction) (Nearest Town)

(3) Topography: Hilly
(Hilly) (Flat) (Level)

(4) Purpose of Well: Domestic
(Domestic Irrigation
Municipal, Industrial, Other)

Description & Color of Materials
Sand, Clay, Red Clay, Shell, etc.

Thick-
ness
Feet

Depth
Feet

<u>yellow sand-clay</u>	<u>72</u>	<u>72</u>
<u>blue clay</u>	<u>226</u>	<u>298</u>
<u>sand</u>	<u>27</u>	<u>325</u>


CODED

Information upon completion of well:

- (1) Diameter 2 inches.
- (2) Total Depth 325 feet.
- (3) Water Level 60 feet below top of ground.
- (4) Cased to all, Size 2"
- (5) Screen: Size 2", Length 10'
- (6) Were any formations sealed against pollution?
 yes, no.

If YES depth of formation surface
Why _____

Drillers Remarks: _____

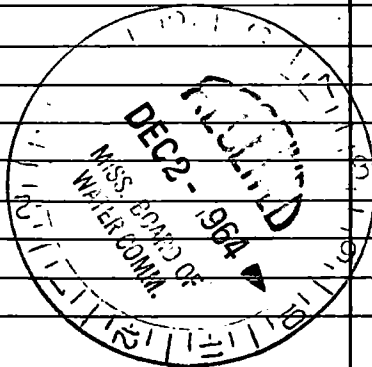

(Use Back Side)

Well No.

0000

... ..

... ..

... ..

... ..

...

...

