

HAR.

MISSISSIPPI BOARD OF WATER COMMISSIONERS

J 60

10-2-64

WATER WELL DRILLERS LOG

CODED

Date: 10-2, 1964, Driller: Sutter Well Works County Harrison (Name)

(1) Owner of Land: Randolph Padon (Name)

Rt. 1 Pass Christian, Miss. (Address)

(2) Location: NW 1/4, NW 1/4, Sec. 7 T7S R13W

3 miles S of Vidalia, (distance) (direction) (Nearest Town)

(3) Topography: Hilly (Hilly) (Flat) (Level)

(4) Purpose of Well: domestic (Domestic Irrigation Municipal, Industrial, Other)

Description & Color of Materials Sand, Clay, Red Clay, Shell, etc.	Thick- ness Feet	Depth Feet
Clay	56	56
sand + clay streaks with clay 165 to 232	201	257
Sand	16	273

CODED

Information upon completion of well:

(1) Diameter 2 inches.

(2) Total Depth 273 feet.

(3) Water Level 34 feet below top of ground.

(4) Cased to all, Size 2"

(5) Screen: Size 2", Length 10'


(6) Were any formations sealed against pollution?

yes, no. (checked)

If YES depth of formation

Why

Drillers Remarks:

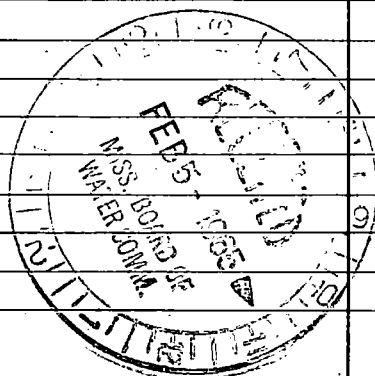

(Use Back Side)

Well No.

