

J 61
10-21-64

WATER WELL DRILLERS LOG

CODED

Date: Oct 21, 1964, Driller: J. Beall County: Harrison
(Name)

(1) Owner of Land: J. V. Slade
(Name)
RT 1 Box 128 Bass
(Address)
Christian

(2) Location: SW 1/4, NW 1/4, Sec 30 T7 R13
10 miles N, of Bass
(distance) (direction) (Nearest Town)
Christian

(3) Topography: (Hilly) (Flat) (Level)

(4) Purpose of Well: Home
(Domestic Irrigation
Municipal, Industrial, Other)

Description & Color of Materials Sand, Clay, Red Clay, Shell, etc.	Thick- ness Feet	Depth Feet
<u>2 2 1/2 Red Clay</u>	<u>22</u>	<u>22</u>
<u>Sand & fine gravel</u>	<u>80</u>	<u>102</u>
<u>Hard Blue mud</u>	<u>70</u>	<u>172</u>
<u>Fine sand</u>	<u>60</u>	<u>232</u>
<u>Hard Blue mud</u>	<u>80</u>	<u>312</u>
<u>Fine sand</u>	<u>90</u>	<u>402</u>
<u>Hard Blue mud</u>	<u>20</u>	<u>429</u>
<u>Water sand</u>	<u>56</u>	<u>483</u>

CODED

Information upon completion of well:

(1) Diameter: 2" x 1 1/4" inches.

(2) Total Depth: 483 feet.

(3) Water Level: Small flow feet below top of ground.

(4) Cased to _____, Size _____.


(5) Screen: Size 1/4", Length 15'.

(6) Were any formations sealed against pollution?
_____ yes, _____ no.

If YES depth of formation _____

Why _____

Drillers Remarks: _____

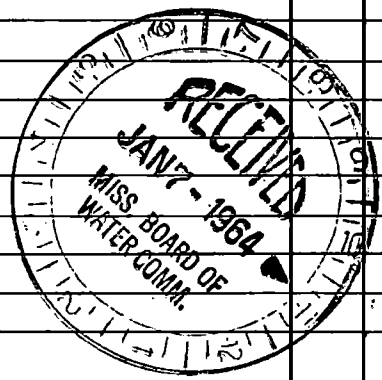

(Use Back Side)

Well No.

1111111111