

HAR.
J62

MISSISSIPPI BOARD OF WATER COMMISSIONERS

12-20-64

WATER WELL DRILLERS LOG

CODED

Date: 12-20, 1964, Driller: J. Beech County Harrison

(Name)

(1) Owner of Land Billy Crews
(Name)
RT 1 Box 55 Christian
(Address)

(2) Location: SE 1/4, NE 1/4, Sec 32 T 7 N 3
10 miles North, of Pass Christian
(distance) (direction) (Nearest Town)

(3) Topography: X
(Hilly) (Flat) (Level)

(4) Purpose of Well: Home
(Domestic Irrigation
Municipal, Industrial, Other)

Description & Color of Materials Sand, Clay, Red Clay, Shell, etc.	Thick- ness Feet	Depth Feet
<u>Red Clay & sand</u>	<u>42</u>	<u>42</u>
<u>Coarse white sand</u>	<u>63</u>	<u>105</u>
<u>Fine gravel</u>	<u>21</u>	<u>126</u>
<u>Soft mud Blue</u>	<u>21</u>	<u>147</u>
<u>White coarse sand</u>	<u>21</u>	<u>168</u>
<u>Fine sand</u>	<u>42</u>	<u>210</u>
<u>Hard Blue mud</u>	<u>21</u>	<u>231</u>
<u>Fine Blue sand</u>	<u>18</u>	<u>249</u>
<u>Hard Blue mud</u>	<u>80</u>	<u>329</u>
<u>Soft Blue mud</u>	<u>60</u>	<u>389</u>
<u>Fine sand</u>	<u>30</u>	<u>419</u>
<u>66 ft water sand</u>		<u>485</u>

Information upon completion of well:

(1) Diameter 2" x 1 1/4" inches.

(2) Total Depth 485 feet.

(3) Water Level 5 ft feet below top of ground.

(4) Cased to _____, Size _____

(5) Screen: Size 1 1/4", Length 15 ft
60 gauge screen


(6) Were any formations sealed against pollution?
_____ yes, _____ no.

CODED

If YES depth of formation _____

Why _____

Drillers Remarks: _____

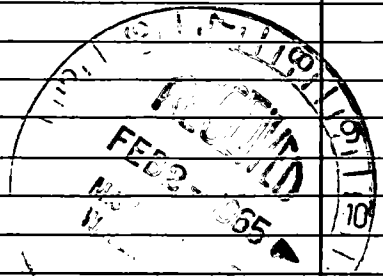

(Use Back Side)

Well No.

1900

Handwritten notes in Arabic script, possibly a list or account, located in the upper left quadrant.

Handwritten notes in Arabic script, located in the upper right quadrant.

Handwritten signature or name in Arabic script, located in the middle right area.

Handwritten signature or name in Arabic script, located in the lower right area.

Handwritten signature or name in Arabic script, located in the lower middle area.