

J63

1-16-65

WATER WELL DRILLERS LOG

**CODED**

Jan

Date: ~~1-16~~ -16, 1965, Driller: J. Beed

County Harrison

(Name)

(1) Owner of Land: Urron Beed

(Name)

RT 1 Box 136 Pass Christian

(Address)

(2) Location: SW 1/4, SE 1/4, Sec. 19 T13R7

10 miles W, of Pass Christian

(distance)

(direction)

(Nearest Town)

(3) Topography: X (Hilly) (Flat) (Level)

(4) Purpose of Well: Home  
(Domestic Irrigation, Municipal, Industrial, Other)

Description & Color of Materials Sand, Clay, Red Clay, Shell, etc.	Thick- ness Feet	Depth Feet
<u>Red Clay &amp; sand</u>	<u>30</u>	<u>30</u>
<u>White sand</u>	<u>50</u>	<u>80</u>
<u>Hard Hard Blue mud</u>	<u>20</u>	<u>100</u>
<u>Water sand</u>	<u>36</u>	<u>136</u>

Information upon completion of well:

(1) Diameter 2" x 1/4" inches.

(2) Total Depth 136 feet.

(3) Water Level 46 1/2 ft feet below top of ground.

(4) Cased to \_\_\_\_\_, Size \_\_\_\_\_

(5) Screen: Size 1/4", Length 10 ft

(6) Were any formations sealed against pollution?


\_\_\_\_\_ yes, \_\_\_\_\_ no.

If YES depth of formation \_\_\_\_\_

Why \_\_\_\_\_

Drillers Remarks: \_\_\_\_\_

**CODED**

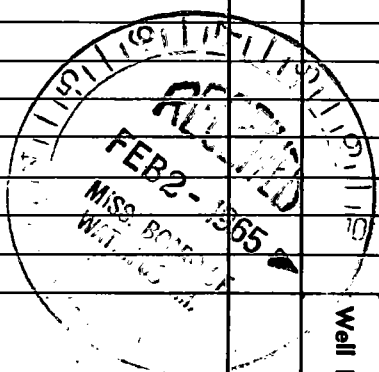

Well No.

(Use Back Side)

1000

1000

1000

X

10

1000