

HAR.

J-64

3-25-65

MISSISSIPPI BOARD OF WATER COMMISSIONERS

WATER WELL DRILLERS LOG

CODED

Date: 3-25, 19 65, Driller: Suttell Well Works County Harrison

(Name)

(1) Owner of Land: W. P. Bosworth (Name)

Bay St. Louis, Miss. (Address)

(2) Location: NW 1/4, NE 1/4, Sec. 15 T25R13W

5 miles N of Oshtemo (distance) (direction) (Nearest Town)

(3) Topography: Hilly (Hilly) (Flat) (Level)

(4) Purpose of Well: domestic (Domestic Irrigation Municipal, Industrial, Other)

Description & Color of Materials Sand, Clay, Red Clay, Shell, etc.	Thick- ness Feet	Depth Feet
clay	10	10
sand w/clay streaks	20	30
clay	94	124
sand	94	218
clay w/sand streaks	218	436
sand	44	480

Information upon completion of well:


- (1) Diameter 2 inches.
- (2) Total Depth 480 feet.
- (3) Water Level 62 feet below top of ground.
- (4) Cased to all, Size 2"
- (5) Screen: Size 2", Length 10'
- (6) Were any formations sealed against pollution?
yes, no.

If YES depth of formation _____


Why _____

Drillers Remarks: _____

CODED

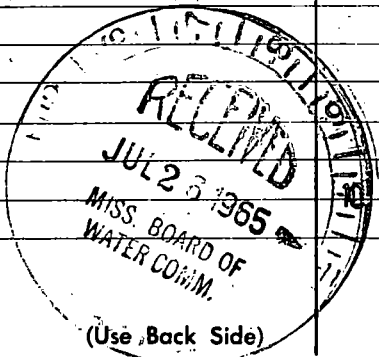

Well No.

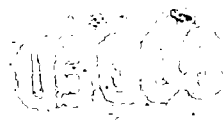

The document contains several pages of handwritten text, which is extremely faint and mostly illegible. The handwriting appears to be in a cursive or semi-cursive style, possibly from the mid-20th century. There are some words and numbers that can be partially discerned, such as '1234' in the stamp, 'on 11/21/50', and 'page 2'. The text is scattered across the pages, with some lines appearing to be underlined or otherwise formatted. The overall quality of the document is poor, with significant fading and noise, making it difficult to transcribe accurately.