

HAR.

WATER WELL DRILLERS LOG

CODED

Date: 8-5, 19 65, Driller: Sutter Well Works County Harrison
8-5-65 (Name)

(1) Owner of Land: Hayward Ladner
(Name)
Rt. 1 Pass Christian, Miss.
(Address)

(2) Location: SW 1/4, SW 1/4, Sec. 13 T5R13, W
6 miles N of Chever
(distance) (direction) (Nearest Town)

(3) Topography: Hilly
(Hilly) (Flat) (Level)

(4) Purpose of Well: Domestic
(Domestic Irrigation
Municipal, Industrial, Other)

Description & Color of Materials Sand, Clay, Red Clay, Shell, etc.	Thick- ness Feet	Depth Feet
<u>old well</u>	<u>60</u>	<u>60</u>
<u>sand</u>	<u>28</u>	<u>88</u>
<u>clay</u>	<u>42</u>	<u>130</u>
<u>sand</u>	<u>55</u>	<u>185</u>
<u>Clay - sand streaks</u>	<u>199</u>	<u>384</u>
<u>clay</u>	<u>49</u>	<u>433</u>
<u>sand</u>	<u>36</u>	<u>469</u>

Information upon completion of well:

(1) Diameter 2 inches.

(2) Total Depth 469 feet.

(3) Water Level 53 feet below top of ground.

(4) Cased to all, Size 2"

(5) Screen: Size 2", Length 10'


(6) Were any formations sealed against pollution?
 yes, no.

If YES depth of formation Surface

Why _____

Drillers Remarks: _____

CODED

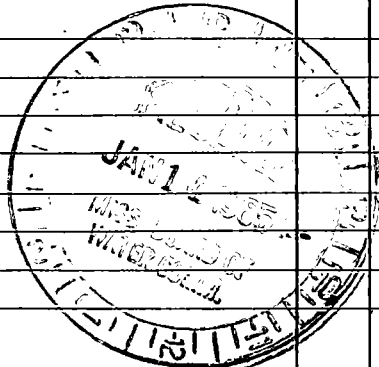

(Use Back Side)

Well No.

