

J68

8-28-65

WATER WELL DRILLERS LOG

CODED

Date: Aug 28 1965, Driller: J Bud County Harrison
 (Name)

(1) Owner of Land: Lacy Noilet
 (Name)
Rt 1 Sam Christian
 (Address)

(2) Location: SE 1/4, NW 1/4, Sec 15 T7 R13
6 miles N of Delata
 (distance) (direction) (Nearest Town)

(3) Topography: X (Hilly) (Flat) (Level)

(4) Purpose of Well: Home
 (Domestic Irrigation, Municipal, Industrial, Other)

Description & Color of Materials Sand, Clay, Red Clay, Shell, etc.	Thick- ness Feet	Depth Feet
<u>Red Clay</u>	<u>25</u>	<u>25</u>
<u>sand & gravel</u>	<u>35</u>	<u>60</u>
<u>white clay</u>	<u>35</u>	<u>95</u>
<u>Blue mud</u>	<u>28</u>	<u>123</u>
<u>fine sand</u>	<u>13</u>	<u>136</u>
<u>Blue mud</u>	<u>59</u>	<u>195</u>
<u>fine sand</u>	<u>30</u>	<u>225</u>
<u>Hard Blue mud</u>	<u>231</u>	<u>456</u>
<u>water sand</u>	<u>50</u>	<u>506</u>


Information upon completion of well:

- (1) Diameter 2 1/4 inches.
- (2) Total Depth 506 feet.
- (3) Water Level 73 feet below top of ground.
- (4) Cased to _____, Size _____
- (5) Screen: Size 1/4", Length 15 ft
- (6) Were any formations sealed against pollution?
 _____ yes, _____ no.

If YES depth of formation _____
 Why _____

Drillers Remarks:
Back filled with sand

CODED

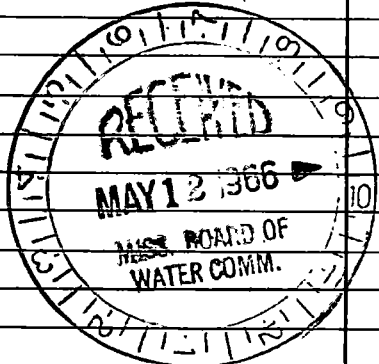

(Use Back Side)

Well No.

0000

11