

HAR. MISSISSIPPI BOARD OF WATER COMMISSIONERS

J70
11-27-65

WATER WELL DRILLERS LOG

CODED

Date: 11-27, 1965, Driller: Sutter Well Works County Harrison
(Name)

(1) Owner of Land: Falcomb - Harrison
(Name)
Pass Christian Miss.
(Address)

(2) Location: NE 1/4, NE 1/4, Sec. 36 T. 75 R. 13, W

3 miles N, of Ceres
(distance) (direction) (Nearest Town)

(3) Topography: Hilly
(Hilly) (Flat) (Level)

(4) Purpose of Well: Domestic
(Domestic Irrigation
Municipal, Industrial, Other)

Description & Color of Materials Sand, Clay, Red Clay, Shell, etc.	Thick- ness Feet	Depth Feet
Clay	10	10
Sand to gravel	88	98
Clay	30	128
Sand	16	144
Clay	36	180
Sand	23	203
Clay	153	356
Sand	39	395
Clay	40	435
Sand	31	466
Clay	23	489
Sand	70	559
Clay	73	632
Sand	103	735

Information upon completion of well:

(1) Diameter 4 inches.

(2) Total Depth 735 feet.

(3) Water Level 12 feet below top of ground.

(4) Cased to all, Size 4"

(5) Screen: Size 4", Length 20'


(6) Were any formations sealed against pollution?
 yes, no.

CODED

If YES depth of formation Surface

Why _____

Drillers Remarks: _____

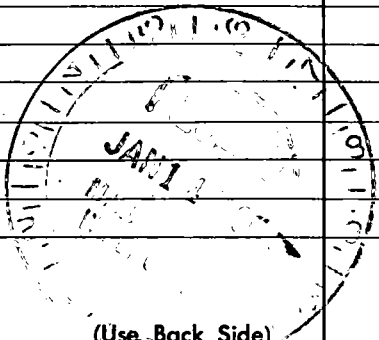

(Use Back Side)

Well No. _____

