

HAR.

MISSISSIPPI BOARD OF WATER COMMISSIONERS

J 71  
2-14-66

WATER WELL DRILLERS LOG

**CODED**

Date: 2-14, 1966, Driller: Little Well Works County Harrison  
(Name)

(1) Owner of Land: Alvin Peterson  
(Name)  
Rt. 1 Pass Christian, Miss.  
(Address)

(2) Location: SW 1/4, NE 1/4, Sec. 27 T75R13, W  
3 miles NW of St. Louis  
(distance) (direction) (Nearest Town)

(3) Topography: Hilly  
(Hilly) (Flat) (Level)

(4) Purpose of Well: domestic  
(Domestic Irrigation  
Municipal, Industrial, Other)

Description & Color of Materials  
Sand, Clay, Red Clay, Shell, etc.

Thick-  
ness  
Feet

Depth  
Feet

Clay	20	20
Clay - sand streaks	120	140
Sand	11	151
Clay	96	227
Sand	27	254
Clay	3	257

**CODED**

Information upon completion of well:

(1) Diameter 2 inches.

(2) Total Depth 257 feet.

(3) Water Level 55 feet below top of ground.

(4) Cased to all, Size 2"

(5) Screen: Size 2", Length 10'


(6) Were any formations sealed against pollution?

yes,  no.

If YES depth of formation \_\_\_\_\_

Why \_\_\_\_\_

Drillers Remarks: \_\_\_\_\_

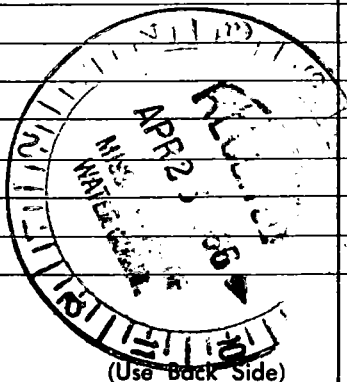

(Use Back Side)

Well No.

