

J72

5-30-66 WATER WELL DRILLERS LOG

CODED

Date: May 30, 1966, Driller: L. Bell County Harrison
 (Name)

- (1) Owner of Land: Larry Johnson
 (Name)
Rt. 1, Pass Christian
 (Address)
- (2) Location: NE 1/4, NW 1/4, Sec. 7 T.7R13
9 miles North of Pass Christian
 (distance) (direction) (Nearest Town)
- (3) Topography: (Hilly) (Flat) (Level)
- (4) Purpose of Well: Home
 (Domestic Irrigation
 Municipal, Industrial, Other)

Description & Color of Materials Sand, Clay, Red Clay, Shell, etc.	Thick- ness Feet	Depth Feet
<u>Red Clay</u>	<u>10</u>	<u>10</u>
<u>soft mud</u>	<u>15</u>	<u>25</u>
<u>white sand</u>	<u>30</u>	<u>55</u>
<u>blue mud</u>	<u>55</u>	<u>110</u>
<u>fine sand</u>	<u>10</u>	<u>120</u>
<u>Hard mud</u>	<u>12</u>	<u>132</u>
<u>strater</u>	<u>44</u>	<u>176</u>

CODED


Information upon completion of well:

- (1) Diameter 2-1/2 inches.
- (2) Total Depth 176 feet.
- (3) Water Level small flow feet below top of ground.
- (4) Cased to _____, Size _____.
- (5) Screen: Size 1/4, Length 15.
- (6) Were any formations sealed against pollution?
 _____ yes, _____ no.

If YES depth of formation _____

Why _____

Drillers Remarks: _____

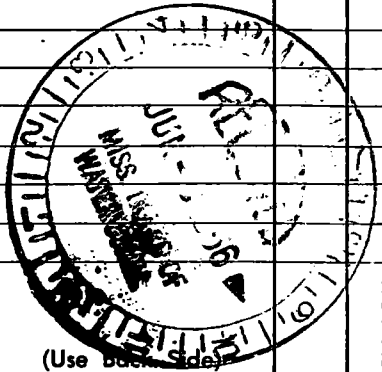

(Use back side)

Well No.

0000