

HARRISON
J 79
6-67

MISSISSIPPI
BOARD OF WATER COMMISSIONERS
416 North State Street
Jackson, Mississippi 39201

WATER WELL DRILLERS LOG

CODED

6-8 19 67 Butter Well Works Harrison
date well completed firm name county well located

LANDOWNER: JAS. LADATO
R. I. Pass Christian
Miss.
(mailing address)

WELL LOCATION:
sec. 13 T. 7 S. R. 13 W.
5 miles NE of Delisle
(distance) (direction) (nearest town)

WELL PURPOSE: home
(home, irrigation, municipal, industrial)

WELL COMPLETION DATA:

- (1) diameter (inches) 2
- (2) total depth (feet) 364
- (3) static water level (feet) 47 below top of ground.
- (4) casing galv. 354'
(material) (depth)
2" if telescope see back.
(size)
- (5) screen 10' 364'
(length) (depth to top)
2" stainless steel
(size) (material)
- (6) pump 1 1/2 15
(HP) (yield gpm)
elec
(type power)
- (7) electric log no
(yes or no)

(organization running log)
- (8) how well bottom plugged B.P. value

description of formations encountered	from	to
<u>Clay</u>	<u>0</u>	<u>18</u>
<u>sand</u>	<u>18</u>	<u>82</u>
<u>Clay</u>	<u>82</u>	<u>89</u>
<u>sand</u>	<u>89</u>	<u>110</u>
<u>Clay</u>	<u>110</u>	<u>180</u>
<u>sand</u>	<u>180</u>	<u>190</u>
<u>Clay</u>	<u>190</u>	<u>342</u>
<u>sand</u>	<u>342</u>	<u>364</u>


CODED



DRILLERS REMARKS:

If well telescopes please sketch and show depths.

GROUND LEVEL

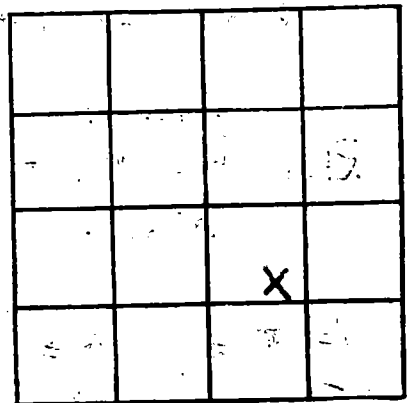

SECTION 13

Please indicate well location X.

ADDITIONAL INFORMATION

If more than one screen, show locations of each on sketch.