

HARRISON
J 80
6-67

MISSISSIPPI
BOARD OF WATER COMMISSIONERS
416 North State Street
Jackson, Mississippi 39201

CODED

WATER WELL DRILLERS LOG

6-5 1967 date well completed
Sutter Well Works firm name
Harrison county well located

LANDOWNER: PENALDER LADNER

Rt. 1 Box 245-A

Pass Christian Miss
(mailing address)

WELL LOCATION:

sec. 5 T 7 S R 13 E W
3 miles S of Vidalia
(distance) (direction) (nearest town)

WELL PURPOSE: home
(home, irrigation, municipal, industrial)

WELL COMPLETION DATA:

- (1) diameter (inches) 2
- (2) total depth (feet) 274
- (3) static water level (feet) 18 below top of ground.
- (4) casing Galv. 264' (material) (depth)
2" (size) if telescope see back.
- (5) screen 10' 264' (length) (depth to top)
2" Stainless Steel (size) (material)
- (6) pump 1/2 10 (HP) (yield gpm)
p/ea (type power)
- (7) electric log no (yes or no)

(organization running log)


(8) how well bottom plugged BP Value

description of formations encountered

from to

Clay	0	63
Sand	63	73
Clay	73	254
Sand	254	274


CODED

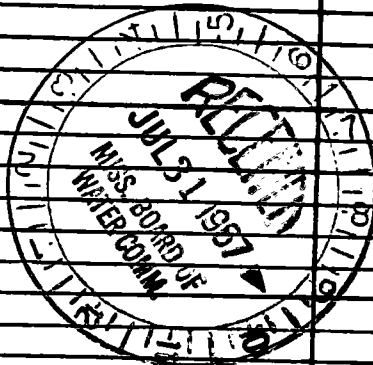

DRILLERS REMARKS:

If well telescopes please sketch and show depths.

GROUND LEVEL

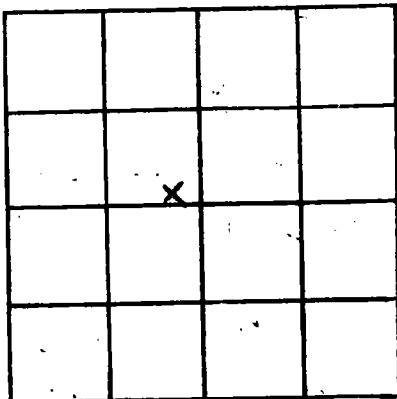

SECTION 5

Please indicate well location X.

ADDITIONAL INFORMATION

If more than one screen, show locations of each on sketch.