


Harrison
J 83
10-67

MISSISSIPPI
BOARD OF WATER COMMISSIONERS
416 North State Street
Jackson, Mississippi 39201

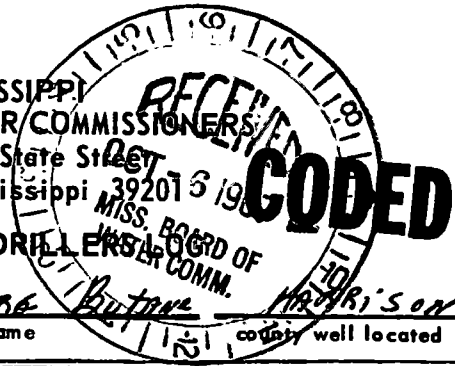

WATER WELL DRILLERS

10-3 1967 HATTIESBURG Butane Harrison
date well completed firm name county well located

LANDOWNER: Wilton T. Overas
Wilton

description of formations encountered	from	to
yellow clay	0	12
white clay	13	18
Red clay	19	20
Red sand	21	25
gray clay	26	51
Blue clay	52	75
Blue sand	76	78
Blue clay	79	142
Blue sand	143	165
Blue sand	166	240
Blue sand & clay	241	280
Blue sand	281	303

Rt. 1 Box 138B
Pass Christian, Miss.
(mailing address)

WELL LOCATION:
sec. 18 T 7 S R 13 W
6 miles NORTH of Pass Christian
(distance) (direction) (nearest town)

WELL PURPOSE: HOME
(home, irrigation, municipal, industrial)

- WELL COMPLETION DATA:
- (1) diameter (inches) 2"
 - (2) total depth (feet) 303'
 - (3) static water level (feet) 21 below above top of ground.
 - (4) casing Galv. pipe 2 1/2" (material) (depth)
 - 2" (size) if telescope see back.
 - (5) screen 10' (length) 293' (depth to top)
 - 2" (size) BRONZE (material)
 - (6) pump 1 (HP) MSE (yield gpm)
 - electric (type power)
 - (7) electric log NO (yes or no)
 - NO (organization running log)
 - (8) how well bottom plugged BACK WASH VALVE

CODED

DRILLERS REMARKS:

If well telescopes please sketch and show depths.

GROUND LEVEL

18			
X			

SECTION 18

Please indicate well location X.

ADDITIONAL INFORMATION

If more than one screen, show locations of each on sketch.