

Harrison
J 84
11-67

MISSISSIPPI
 BOARD OF WATER COMMISSIONERS
 416 North State Street
 Jackson, Mississippi 39201

CODED

WATER WELL DRILLERS LOG

11-3 1967 Sutter Well Works Harrison
 date well completed firm name county well located

LANDOWNER: E. M. Peterson

description of formations encountered

from

to

Rt. 1 Box 231

Pen Christian, Miss.
 (mailing address)

Clay	0	100
sand	100	149
Clay	149	182
sand	182	208
Clay	208	256
sand	256	374

WELL LOCATION:

sec 21 T 7 R 13 S W
 miles N of Delisle
 (distance) (direction) (nearest town)

WELL PURPOSE: home
 (home, irrigation, municipal, industrial)

WELL COMPLETION DATA:

(1) diameter (inches) 2
 (2) total depth (feet) 274
 (3) static water level (feet) 54 below
 top of ground. above

CODED

(4) casing galv. 264'
 (material) (depth)
2"
 (size) if telescope see back.

(5) screen 10' 264'
 (length) (depth to top)
2" stainless steel
 (size) (material)


(6) pump 1 10
 (HP) (yield gpm)
elec
 (type power)

(7) electric log no
 (yes or no)

(organization running log)

(8) how well bottom plugged B.P. Value

DRILLERS REMARKS:

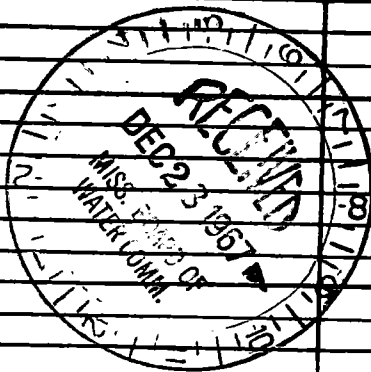

If well telescopes please sketch and show depths.

GROUND LEVEL

			X

SECTION 21

Please indicate well location X.

ADDITIONAL INFORMATION

If more than one screen, show locations of each on sketch.