

Harrison
 888
 8-68

CODED

MISSISSIPPI
 BOARD OF WATER COMMISSIONERS
 416 North State Street
 Jackson, Mississippi 39201

CODED

WATER WELL DRILLERS LOG

Aug. 17 1968 *Ladnier's Well Works* *Harrison*
 date well completed firm name county well located

LANDOWNER: *Mr. Lind*

description of formations encountered

from to

Pass Christian
 (mailing address)

<i>Red clay</i>	<i>0</i>	<i>20</i>
<i>white sand</i>	<i>20</i>	<i>40</i>
<i>Red clay</i>	<i>40</i>	<i>100</i>
<i>Red sand + gravel</i>	<i>100</i>	<i>140</i>
<i>Purple clay</i>	<i>140</i>	<i>200</i>
<i>Blue clay</i>	<i>200</i>	<i>320</i>
<i>sand rock</i>	<i>320</i>	<i>350</i>
<i>Blue coarse sand</i>	<i>350</i>	<i>380</i>

WELL LOCATION:

sec. *4* T. *7* N. R. *13* E.
 (distance) (direction) (nearest town)
10 miles *N* of *Medicine*

WELL PURPOSE: *Home*
 (home, irrigation, municipal, industrial)

WELL COMPLETION DATA:


- (1) diameter (inches) *2 inch*
- (2) total depth (feet) *380'*
- (3) static water level (feet) *50* below top of ground.
- (4) casing *Galv.*, *370'*
 (material) (depth)
- 2 in.* If telescope see back.
 (size)
- (5) screen *10 ft.*, *370'*
 (length) (depth to top)
- 2 in.*, *55*
 (size) (material)
- (6) pump *1* *5*
 (HP) (yield gpm)
- Elec.*
 (type power)
- (7) electric log *no*
 (yes or no)

CODED

(organization running log)


(8) how well bottom plugged
Ball Check

DRILLERS REMARKS:

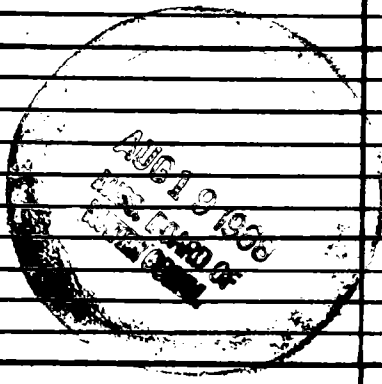

If well telescopes please sketch and show depths.

GROUND LEVEL

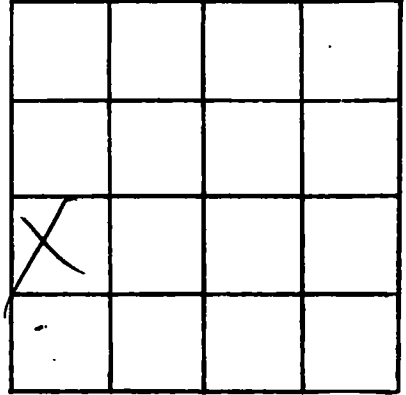

SECTION 4

Please indicate well location X.

ADDITIONAL INFORMATION

Lined area for additional information.

If more than one screen, show locations of each on sketch.