

MISSISSIPPI
BOARD OF WATER COMMISSIONERS
416 North State Street
Jackson, Mississippi 39201

CODED

WATER WELL DRILLERS LOG

Aug. 9 1968 Ladnie's Well Works Harrison
date well completed firm name county well located

LANDOWNER: Mr. Cuevas

description of formations encountered

from to

Lower Rd.

Pass Christian, Miss
(mailing address)

<u>Red clay</u>	<u>0</u>	<u>40</u>
<u>Yellow sand + clay</u>	<u>40</u>	<u>100</u>
<u>Red clay</u>	<u>100</u>	<u>160</u>
<u>Blue clay</u>	<u>160</u>	<u>310</u>
<u>Blue fine sand</u>	<u>310</u>	<u>330</u>
<u>Blue clay</u>	<u>330</u>	<u>430</u>
<u>Fine sand</u>	<u>430</u>	<u>450</u>
<u>Coarse blue sand</u>	<u>450</u>	<u>480</u>

WELL LOCATION:

sec. 38 T. 7 N. R. 13 E. W
4 1/2 miles N of Cuevas
(distance) (direction) (nearest town)

WELL PURPOSE: Home
(home, irrigation, municipal, industrial)

WELL COMPLETION DATA:


- (1) diameter (inches) 2 inch
- (2) total depth (feet) 480
- (3) static water level (feet) 50 below above top of ground.
- (4) casing Galvanized 470'
(material) (depth)
- 2 in. If telescope see back.
(size)
- (5) screen 10 ft., 470'
(length) (depth to top)
- 2 in., 55
(size) (material)
- (6) pump 1 5
(HP) (yield gpm)
- Elec.
(type power)
- (7) electric log no
(yes or no)

CODED

(organization running log)


(8) how well bottom plugged
Ball check

DRILLERS REMARKS:

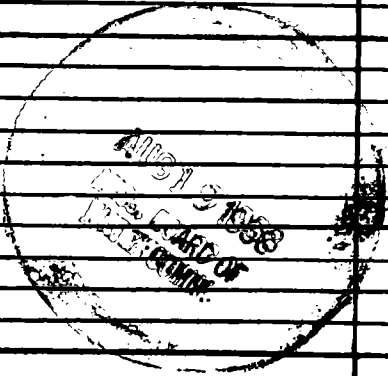

If well telescopes please sketch and show depths.

GROUND LEVEL

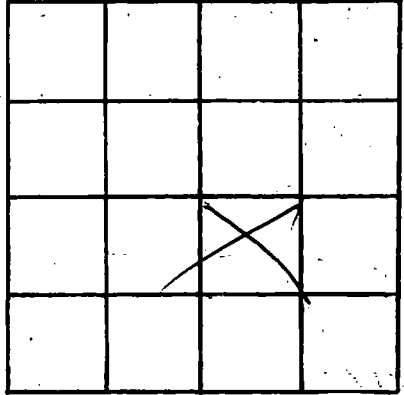

SECTION 38

Please indicate well location X.

ADDITIONAL INFORMATION

If more than one screen, show locations of each on sketch.