

ltr. June 12-68  
Converted copy card 6/19/68 JDR

MISSISSIPPI  
BOARD OF WATER COMMISSIONERS  
416 North State Street  
Jackson, Mississippi 39201

**CODED**

WATER WELL DRILLERS LOG *Harrison*

11-2 date well completed     1967 Peaton Well Serv firm name     Harrison county well located

LANDOWNER: Wilfred Frederick  
Rt 1 Box 245  
Pass Christian, Miss  
(mailing address)

| description of formations encountered | from to |      |
|---------------------------------------|---------|------|
|                                       | feet    | feet |
| Red Clay                              | 0       | 30   |
| Sand                                  | 30      | 56   |
| White Clay                            | 56      | 68   |
| Blue Clay                             | 68      | 175  |
| Grey Sand                             | 175     | 216  |


WELL LOCATION:  
sec. X T. 7 N. R. 13 E.  
23 miles SE of Standard  
(distance) (direction) (nearest town)  
VIDALIA

WELL PURPOSE: Home  
(home, irrigation, municipal, industrial)

WELL COMPLETION DATA:  
(1) diameter (inches) 4 1/2 Drilled  
(2) total depth (feet) 212  
(3) static water level (feet) 80 below top of ground.  
(4) casing Galv. steel 207, (material) (depth)  
2" (size) if telescope see back.  
(5) screen 5', 207 (length) (depth to top)  
2", S. Steel (size) (material)  
(6) pump 1 1/2, 5 (HP) (yield gpm)  
Elec (type power)  
(7) electric log NO (yes or no)  
(organization running log)  
(8) how well bottom plugged Blw. Valve

**CODED**


**CODED**

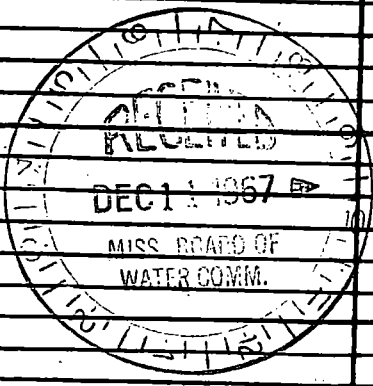

DRILLERS REMARKS:

If well telescopes please sketch and show depths.

GROUND LEVEL

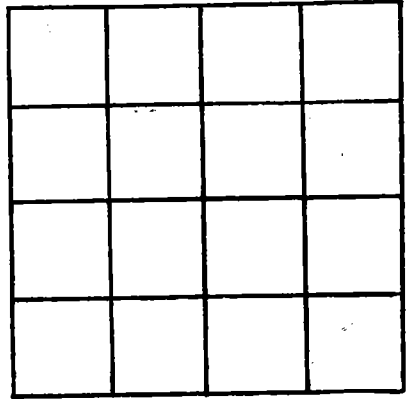

SECTION \_\_\_\_\_

Please indicate well location X.

ADDITIONAL INFORMATION

~~Sect. NOT KNOWN~~  
~~NO HARRISON CO MAP~~  
~~HAS MAP as of 5-68~~

If more than one screen, show locations of each on sketch.