

Harrison  
J 93  
9-12-68 **CODED**

MISSISSIPPI  
 BOARD OF WATER COMMISSIONERS  
 416 North State Street  
 Jackson, Mississippi 39201

WATER WELL DRILLERS LOG

**CODED**

9-12 1968 Penton Well Serv Harrison  
 date well completed firm name county well located

LANDOWNER: Wilford Moran  
Rt 1 Box 129  
Pass Christian Miss  
 (mailing address)

description of formations encountered	From	To
Clay	0	20
yellow clay	20	32
Blue Clay	32	75
Mud	75	88
Blue Clay	88	180
" SAND	180	195


WELL LOCATION:  
 sec. 30 T. 7 S. R. 13 W.  
6 miles East of Kiln  
 (distance) (direction) (nearest town)

WELL PURPOSE: Home  
 (home, irrigation, municipal, industrial)

WELL COMPLETION DATA: 4 1/2 Drilled

- (1) diameter (inches) 2"
- (2) total depth (feet) 195
- (3) static water level (feet) 38 below top of ground.
- (4) casing Galv, 190  
 (material) (depth)  
2" If telescope see back.  
 (size)
- (5) screen 5', 190  
 (length) (depth to top)  
2" S. Steel  
 (size) (material)
- (6) pump 1/2, 4  
 (HP) (yield gpm)  
Elec  
 (type power)
- (7) electric log NO  
 (yes or no)  
 (organization running log)
- (8) how well bottom plugged Blw Valve

**CODED**

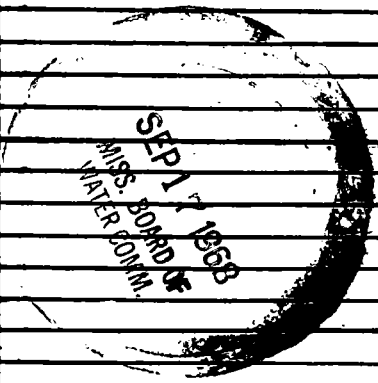

DRILLERS REMARKS:

If well telescopes please sketch and show depths.

GROUND LEVEL

		X	

SECTION 30

Please indicate well location X.

**ADDITIONAL INFORMATION**

If more than one screen, show locations of each on sketch.