

Hanson
J94
9-13-68

MISSISSIPPI
 BOARD OF WATER COMMISSIONERS
 416 North State Street
 Jackson, Mississippi 39201

CODED

WATER WELL DRILLERS LOG

9-13 1968 Sutter Well Works Hanson
 date well completed firm name county well located

LANDOWNER: Henley
 Contracted for by Jim Mitchell Realty
Bildi Miss
 (mailing address)

description of formations encountered	from	to
Clay	0	22
red sand	22	78
Clay	78	248
sand	248	288
Clay	288	380
sand	380	410


WELL LOCATION:
23 T 7 N R 13 E
S W
 miles NE of Pass Christian
 (distance) (direction) (nearest town)

WELL PURPOSE: home
 (home, irrigation, municipal, industrial)

WELL COMPLETION DATA:

- (1) diameter (inches) 2
- (2) total depth (feet) 410
- (3) static water level (feet) 63 below top of ground.
- (4) casing galv. 400'
 (material) (depth)
2"
 (size) if telescope see back.
- (5) screen 10' 400'
 (length) (depth to top)
2" Stainless steel
 (size) (material)
- (6) pump 1 15
 (HP) (yield gpm)
elec
 (type power)
- (7) electric log no
 (yes or no)
 (organization running log)
- (8) how well bottom plugged BP Valve

CODED

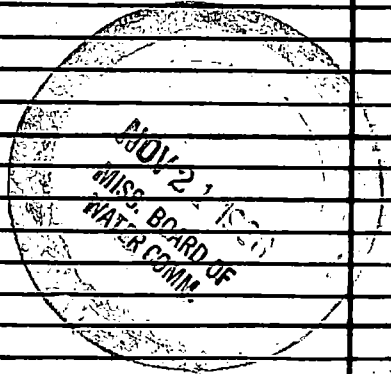

DRILLERS REMARKS:

If well telescopes please sketch and show depths.

GROUND LEVEL

SECTION _____

Please indicate well location X.

ADDITIONAL INFORMATION

If more than one screen, show locations of each on sketch.