

Harrison
 J 95
 10-15-68

MISSISSIPPI
 BOARD OF WATER COMMISSIONERS
 416 North State Street
 Jackson, Mississippi 39201

CODED

WATER WELL DRILLERS LOG

10-15 date well completed 1968 Penton Well Serv firm name Harrison county well located

LANDOWNER: Dale Moran
 Box 216 - Rt. 2
 Pass-Christiana, Miss
 (mailing address)

description of formations encountered	from	to
Surface Clay	0	24
Sand	24	42
Brown Clay	42	65
Blue Clay	65	157
Fine Sand	157	195
Grey Sand	195	216

WELL LOCATION:
 sec. 30 T 7 S R 13 W
 5 1/2 miles East of Kiln
 (distance) (direction) (nearest town)

WELL PURPOSE: Home
 (home, irrigation, municipal, industrial)

WELL COMPLETION DATA: 4 1/2 Drilled


- (1) diameter (Inches) 2'
- (2) total depth (feet) 216
- (3) static water level (feet) 13' below top of ground
- (4) casing Galv. 211 (material) (depth)
- 2" (size) If telescope see back.
- (5) screen 5' 211 (length) (depth to top)
- 0.12 2" 5 Steel (size) (material)
- (6) pump 1/2 9 (HP) (yield gpm)
- Elec (type power)
- (7) electric log No (yes or no)

(organization running log)

(8) how well bottom plugged Brw Valve

DRILLERS REMARKS:

CODED

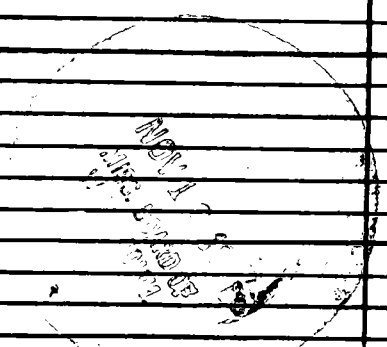

If well telescopes please sketch and show depths.

GROUND LEVEL

	X		

SECTION 30

Please indicate well location X.

ADDITIONAL INFORMATION

If more than one screen, show locations of each on sketch.