

Harrison  
 J96  
 10-30-68

MISSISSIPPI  
 BOARD OF WATER COMMISSIONERS  
 416 North State Street  
 Jackson, Mississippi 39201

WATER WELL DRILLERS LOG

**CODED**

date well completed Oct. 30 1968 firm name Ladner's Well Works county well located Harrison

LANDOWNER: George Taylor  
Pass Christian, Miss  
 (mailing address)

description of formations encountered	from	to
<u>Yellow clay</u>	<u>50 feet</u>	
<u>yellow sand</u>	<u>15 feet</u>	
<u>Yellow clay</u>	<u>70 feet</u>	
<u>Blue clay</u>	<u>300 feet</u>	
<u>Blue sand</u>	<u>25 feet</u>	

WELL LOCATION:  
 sec. 36 T-7 N R-13 E  
 (S) (W)  
6 miles North of Delisle  
 (distance) (direction) (nearest town)

WELL PURPOSE: home  
 (home, irrigation, municipal, industrial)

- WELL COMPLETION DATA:
- (1) diameter (inches) 2 inch
  - (2) total depth (feet) 430 feet
  - (3) static water level (feet) 60 ft below top of ground.
  - (4) casing gal. 420  
 (material) (depth)  
2 inch if telescope see back.  
 (size)
  - (5) screen 10 ft. 420  
 (length) (depth to top)  
2 inch, Stainless steel  
 (size) (material)
  - (6) pump 1 horse 8  
 (HP) (yield gpm)  
Electric  
 (type power)
  - (7) electric log no  
 (yes or no)

**CODED**


(organization running log)  
 (8) how well bottom plugged Ball check

DRILLERS REMARKS:

MISSISSIPPI  
 BOARD OF WATER COMMISSIONERS

If well telescopes please sketch and show depths.

GROUND LEVEL

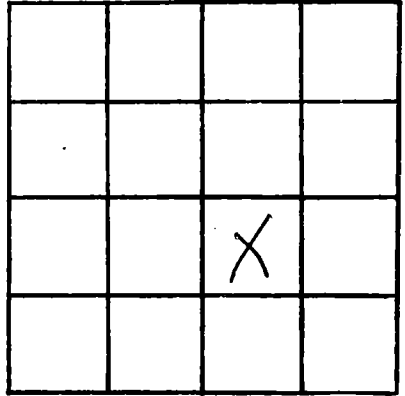

SECTION 36

Please indicate well location X.

ADDITIONAL INFORMATION

If more than one screen, show locations of each on sketch.