

CODED

MISSISSIPPI
BOARD OF WATER COMMISSIONERS
416 North State Street
Jackson, Mississippi 39201

WATER WELL DRILLERS LOG

Harrison Co
J 104
1-70

January 29 1970 Sadain's Well Works Harrison
Date well completed firm name county well located

LANDOWNER: Roy Koemann

Deadeaux, Miss.
(mailing address)

WELL LOCATION:
sec. 3 T. 7 N R. 13 E
S W
8 miles North of Park Plaquemine
(distance) (direction) (nearest town)

WELL PURPOSE: Home
(home, irrigation, municipal, industrial)

WELL COMPLETION DATA:

- (1) diameter (inches) 2 inches
- (2) total depth (feet) 378 ft.
- (3) static water level (feet) 80 below above top of ground.
- (4) casing gal. 363 ft.
(material) (depth)
2 inch if telescope see back.
(size)
- (5) screen 15 ft. 363 ft.
(length) (depth to top)
2 inch Stainless steel
(size) (material)
- (6) pump 2 12
(HP) (yield gpm)
Electric
(type power)
- (7) electric log No
(yes or no)

(organization running log)
- (8) how well bottom plugged Ball Check

description of formations encountered	from	to
<u>Yellow Clay</u>	<u>40</u>	<u>ft.</u>
<u>Yellow Sand</u>	<u>40</u>	<u>ft.</u>
<u>Blue Clay</u>	<u>30</u>	<u>ft.</u>
<u>Fine Blue Sand</u>	<u>10</u>	<u>ft.</u>
<u>Cream-Colored Clay</u>	<u>30</u>	<u>ft.</u>
<u>White Sand</u>	<u>10</u>	<u>ft.</u>
<u>Blue Clay</u>	<u>180</u>	<u>ft.</u>
<u>Coarse Blue Sand</u>	<u>38</u>	<u>ft.</u>


FEB 4 - 1970

DRILLERS REMARKS:

MISS. BD. OF
WATER COMM.

If well telescopes please sketch and show depths.

GROUND LEVEL

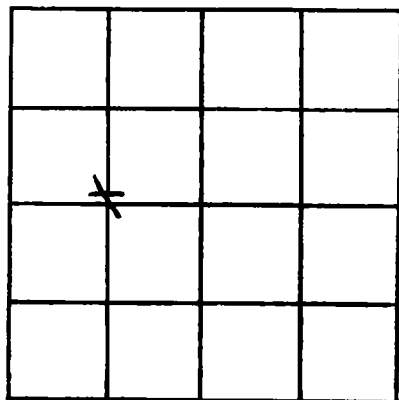

SECTION 3

Please indicate well location X.

ADDITIONAL INFORMATION

If more than one screen,
show locations of each on sketch.