

HARRISON
 J109
 9-9-70

MISSISSIPPI
 BOARD OF WATER COMMISSIONERS
 416 North State Street
 Jackson, Mississippi 39201

CODED

WATER WELL DRILLERS LOG

9-9 1970 R.J. Moore HARRISON
 date well completed firm name county well located


LANDOWNER: <u>Robert Graves</u>	Description of formations encountered	from	to
<u>P.O. Box 391</u>	<u>red clay</u>	<u>0</u>	<u>18</u>
<u>PASS Christian</u> (mailing address) <u>MISS</u>	<u>red sand</u>	<u>18</u>	<u>30</u>
WELL LOCATION: sec. <u>30</u> T. <u>7</u> N. R. <u>13</u> E <u>6</u> miles <u>N</u> of <u>SPRINGVILLE</u> (distance) (direction) (nearest town)	<u>Blue clay</u>	<u>30</u>	<u>230</u>
WELL PURPOSE: (home, irrigation, municipal, industrial)	<u>Gen sand</u>	<u>270</u>	<u>255</u>
WELL COMPLETION DATA: (1) diameter (inches) <u>2"</u>			
(2) total depth (feet) <u>255'</u>			
(3) static water level (feet) <u>55'</u> <u>below</u> top of ground.			
(4) casing <u>9442</u> <u>245'</u> (material) (depth)			
<u> </u> If telescope see back. (size)			
(5) screen <u>2x10</u> <u>245'</u> (length) (depth to top)			
<u>2"</u> <u>SS</u> (size) (material)			
(6) pump <u>1</u> <u>360 HE</u> (HP) (yield gpm)			
<u>etc</u> (type power)			
(7) electric log <u> </u> (yes or no)			
<u> </u> (organization running log)			
(8) how well bottom plugged <u>BA</u> <u> </u>			
DRILLERS REMARKS:			

PAID

SEP 14 1970

If well telescopes please sketch and show depths.

GROUND LEVEL

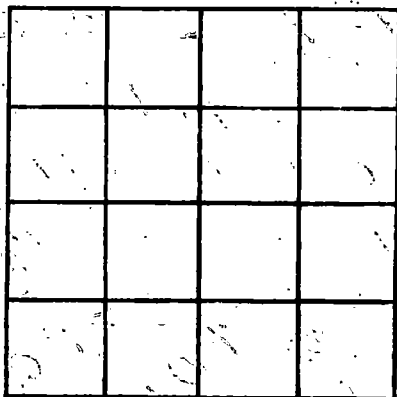

SECTION _____

Please indicate well location X.

ADDITIONAL INFORMATION

If more than one screen, show locations of each on sketch.