

HARRISON
J III
8-29-70

MISSISSIPPI
BOARD OF WATER COMMISSIONERS
416 North State Street
Jackson, Mississippi 39201
WATER WELL DRILLERS LOG

CODED

8-29 1970 C.T. Switzer Well Co. Hancock
date well completed firm name county well located

LANDOWNER: Kenneth Ncaise
Rt. 7 Box 642
PASS Christian, Miss.
(mailing address)

WELL LOCATION:
sec. 4 T. 7 N. R. 13 E
S. W.
6.5 miles N of DELSLE
(distance) (direction) (nearest town)

WELL PURPOSE: home
(home, irrigation, municipal, industrial)

WELL COMPLETION DATA:
(1) diameter (inches) 2"
(2) total depth (feet) 419'
(3) static water level (feet) 76'06" ^{below}/_{above} top of ground.
(4) casing galv. 419'
(material) (depth)
 If telescope see back.
(size)
(5) screen 10' 409'
(length) (depth to top)
008 stainkss steel
(size) (material)
(6) pump 1 5
(HP) (yield gpm)
ELC.
(type power)
(7) electric log NO
(yes or no)

(organization running log)
(8) how well bottom plugged back
pressure valve

description of formations encountered	from	to
CLAY	0	12
SAND	12	20
SAND + gravel	20	40
soft red clay	40	60
mixed	60	80
brown sand	80	100
CLAY	100	139
mixed	139	159
SAND	159	199
CLAY	199	378
SAND, fine	378	398
SAND, fine	398	425

Well set at 419'

CODED


OCT 12 1970

DRILLERS REMARKS:

MISS. DD. OF
WATER COMM.

If well telescopes please sketch and show depths.

GROUND LEVEL

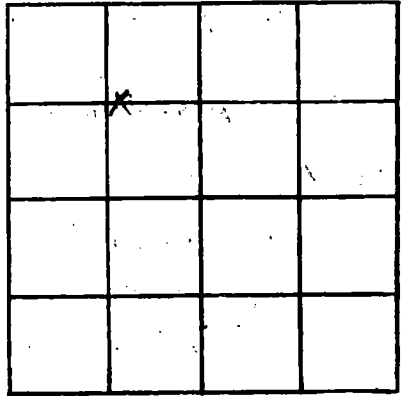

SECTION 4

Please indicate well location X.

ADDITIONAL INFORMATION

If more than one screen, show locations of each on sketch.