

HARRISON  
J 113  
11-25-70

MISSISSIPPI  
 BOARD OF WATER COMMISSIONERS  
 416 North State Street  
 Jackson, Mississippi 39201  
 WATER WELL DRILLERS LOG

**CODED**

11-25-70 19 R. J. Moore HARRISON  
 date well completed firm name county well located

LANDOWNER Eugene Nochaize  
RT #1 240A  
PASS CHRISTIAN MISS  
 (mailing address)

description of formations encountered	from	to
	<u>TOP SOIL</u>	<u>0</u>
<u>Red clay sand</u>	<u>10</u>	<u>14</u>
<u>Red + white clay</u>	<u>14</u>	<u>210</u>
<u>Blue clay</u>	<u>210</u>	<u>450</u>
<u>Blue sand</u>	<u>450</u>	<u>478</u>

WELL LOCATION:  
 sec 9 T 7 N 13 E  
5 1/2 miles N of DELISLE  
 (distance) (direction) (nearest town)

WELL PURPOSE:  
 (home, irrigation, municipal, industrial)

- WELL COMPLETION DATA:
- diameter (inches) 2"
  - total depth (feet) 478'
  - static water level (feet) 40' <sup>below</sup> above top of ground.
  - casing PVC 478'  
 (material) (depth)  
         if telescope see back.  
 (size)
  - screen 2x0 478'  
 (length) (depth to top)  
2" SS  
 (size) (material)
  - pump E 8  
 (HP) (yield gpm)  
E  
 (type power)
  - electric log           
 (yes or no)  
          
 (organization running log)
  - how well bottom plugged BW  
drive

**CODED**


DEC 7 5 1970

MISS. BD. OF  
 WATER COMM.

DRILLERS REMARKS:

If well telescopes please sketch and show depths.

GROUND LEVEL

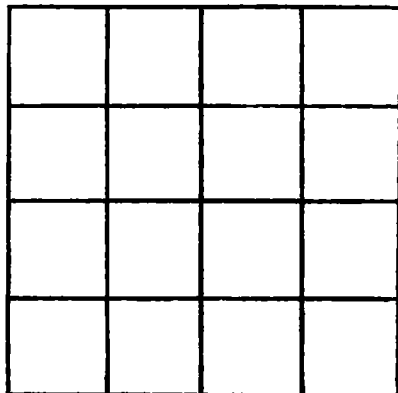

SECTION \_\_\_\_\_

Please indicate well location X.

ADDITIONAL INFORMATION

If more than one screen, show locations of each on sketch.