

Harrison  
8 116  
2-25-69

MISSISSIPPI  
 BOARD OF WATER COMMISSIONERS  
 416 North State Street  
 Jackson, Mississippi 39201

**CODED**

WATER WELL DRILLERS LOG

FEB 25 1969 MCGILL HARRISON  
 date well completed firm name county well located

LANDOWNER: BUFFORD  
NECAISE  
GULFPORT  
 (mailing address)

description of formations  
 encountered

from to

CLAY  
SAND

0 80  
80 101

WELL LOCATION:  
 sec. 14 T 7 N R 13 E  
12 miles N of Belisle  
 (distance) (direction) (nearest town)

WELL PURPOSE: home  
 (home, irrigation, municipal, industrial)

WELL COMPLETION DATA:

- (1) diameter (inches) 2 1/2  
 (2) total depth (feet) 101  
 (3) static water level (feet) 40 below  
 top of ground above

(4) casing galv  
 (material) (depth)

(size) If telescope see back.

(5) screen 5 96  
 (length) (depth to top)

2 SS  
 (size) (material)

(6) pump none 10  
 (HP) (yield gpm)

none  
 (type power)

(7) electric log no  
 (yes or no)

(organization running log)

(8) how well bottom plugged BW

**CODED**


**30 1969**

DRILLERS REMARKS:

MISS. BD. OF  
 WATER

If well telescopes please  
sketch and show depths.

GROUND LEVEL

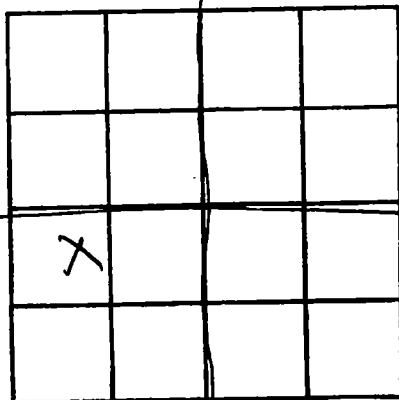

SECTION 14

Please indicate well location X.

ADDITIONAL INFORMATION

If more than one screen,  
show locations of each on sketch.