

MISSISSIPPI
 BOARD OF WATER COMMISSIONERS
 416 North State Street
 Jackson, Mississippi 39201

CODED

WATER WELL DRILLERS LOG

Harrison
9117
2-14-70

Feb. 14 1970 Mr Bill Well Works Harrison
 date well completed firm name county well located

LANDOWNER: MR. HORN
Wendal
Gulfport, Miss.
 (mailing address)

description of formations encountered	from	to
Red clay	0	30
Red sand	30	60
Blue mud	60	280
Fine sand	280	300
Blue mud	300	360
COARSE SAND	360	400

WELL LOCATION:
 sec. 16 T 7 N R. 13 E
0.6 miles North of Deslie
 (distance) (direction) (nearest town)

WELL PURPOSE: Home
 (home, irrigation, municipal, industrial)

WELL COMPLETION DATA:

(1) diameter (inches) 2"

(2) total depth (feet) 400'

(3) static water level (feet) 90' below top of ground.

(4) casing None
 (material) (depth)

No If telescope see back.
 (size)

(5) screen 10' 390
 (length) (depth to top)

2" S.S.
 (size) (material)

(6) pump 1 11
 (HP) (yield gpm)

Electric
 (type power)

(7) electric log No
 (yes or no)

No
 (organization running log)

(8) how well bottom plugged Sand
shark

CODED


FEB 18 1970

MISS. BD. OF
 WATER COMM.

DRILLERS REMARKS: None

If well telescopes please sketch and show depths.

GROUND LEVEL

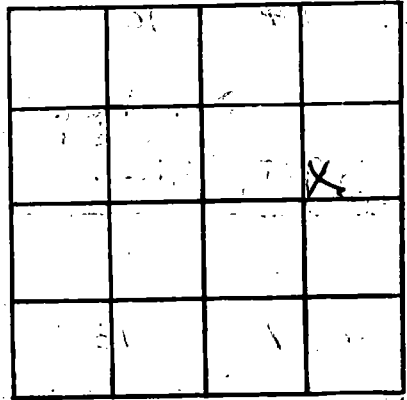

SECTION 16

Please indicate well location X.

ADDITIONAL INFORMATION

If more than one screen, show locations of each on sketch.