

HARRISON
J 125
3-19-71

MISSISSIPPI
 BOARD OF WATER COMMISSIONERS
 416 North State Street
 Jackson, Mississippi 39201
WATER WELL DRILLERS LOG

CODED

3-19-71 19
 date well completed

R. J. Moore
 firm name

HARRISON
 county well located

LANDOWNER: **K. D. WILLIAMS**

description of formations encountered

from

to

RT 2 Box 238

PASS CHRISTIAN, MISS
 (mailing address)

TOP SOIL
RED SAND

0 20
20 64

WELL LOCATION:

sec. **24** T. **2** N. R. **13** E
5 miles **N** of **PINEVILLE**
 (distance) (direction) (nearest town)

WELL PURPOSE:
 (home, irrigation, municipal, industrial)

WELL COMPLETION DATA:

- (1) diameter (inches) **2"**
 (2) total depth (feet) **64'**
 (3) static water level (feet) **50'** ^{below} above top of ground.
 (4) casing **wh** **62'**
 (material) (depth)

CODED

- _____ If telescope see back.
 (size)
 (5) screen **2x10** **50'**
 (length) (depth to top)
2" **CS**
 (size) (material)
 (6) pump _____
 (HP) (yield gpm)

 (type power)
 (7) electric log _____
 (yes or no)

 (organization running log)

(8) how well bottom plugged **SW**
white


DRILLERS REMARKS:

MAR 29 1971

MISS. BD. OF
 WATER COMM.

If well telescopes please sketch and show depths.

GROUND LEVEL

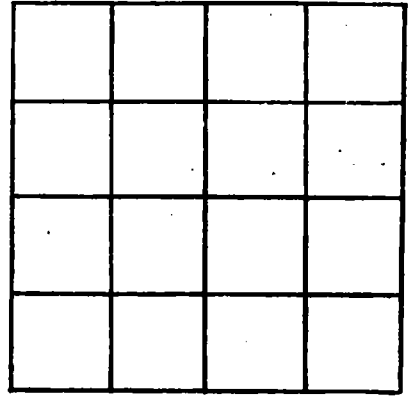

SECTION _____

Please indicate well location X.

ADDITIONAL INFORMATION

If more than one screen, show locations of each on sketch.