

HARRISON
J 127
6-22-70

MISSISSIPPI
BOARD OF WATER COMMISSIONERS
416 North State Street
Jackson, Mississippi 39201

CODED

WATER WELL DRILLERS LOG

June 22 1970 Mc Gill Well Works Harrison
date well completed firm name county well located

LANDOWNER: Clarence Neasie
Rt. 1 Box 245 A
Pass Christian Miss.
(mailing address)

description of formations encountered	from	to
<u>Clay</u>	<u>0</u>	<u>130</u>
<u>slush</u>	<u>130</u>	<u>165</u>
<u>clay</u>	<u>165</u>	<u>237</u>
<u>sand</u>	<u>237</u>	<u>283</u>

WELL LOCATION:
sec. 20 T. 1 N. R. 13 E
13 miles North of Detula
(distance) (direction) (nearest town)

WELL PURPOSE: Domestic
(home, irrigation, municipal, industrial)

WELL COMPLETION DATA:

(1) diameter (inches) 2"

(2) total depth (feet) 283

(3) static water level (feet) 22 below above top of ground.

(4) casing Gal. 273'
(material) (depth)

NO If telescope see back.
(size)

(5) screen 10' 5.5
(length) (depth to top)

2" 5.5
(size) (material)

(6) pump 1 16
(HP) (yield gpm)

electric
(type power)

(7) electric log NO.
(yes or no)

NO.
(organization running log)

(8) how well bottom plugged good
slush

CODED


APR - 1 1971

MISS. BD. OF
WATER COMM.

DRILLERS REMARKS: _____

If well telescopes please sketch and show depths.

GROUND LEVEL

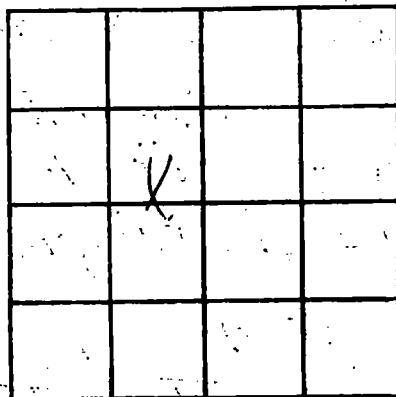

SECTION 20

Please indicate well location X.

ADDITIONAL INFORMATION

If more than one screen, show locations of each on sketch.