

HARRISON
J131
4-8-71

MISSISSIPPI
 BOARD OF WATER COMMISSIONERS
 416 North State Street
 Jackson, Mississippi 39201
WATER WELL DRILLERS LOG

CODED

R. J. Moore

HARRISON

4-8-71 19__
 date well completed

firm name

county well located

LANDOWNER:

HERITAGE INVESTMENTS CO
PO Box 1395

description of formations encountered

from

to

PASS CHRISTIAN, MISS
 (mailing address)

| | | |
|-------------------|------------|------------|
| <i>TOPSOIL</i> | <i>0</i> | <i>12</i> |
| <i>white sand</i> | <i>12</i> | <i>18</i> |
| <i>white clay</i> | <i>18</i> | <i>60</i> |
| <i>Rocky Sand</i> | <i>60</i> | <i>80</i> |
| <i>blue clay</i> | <i>80</i> | <i>267</i> |
| <i>gray sand</i> | <i>267</i> | <i>294</i> |

WELL LOCATION:

sec. *34* T. *7* N. R. *13* E. S. *5* W.
3/4 miles *N* of *Delisle*
 (distance) (direction) (nearest town)

WELL PURPOSE:

(home, irrigation, municipal, industrial)

WELL COMPLETION DATA:

- (1) diameter (inches) *2"*
- (2) total depth (feet) *294'*
- (3) static water level (feet) *65'* ^{below} _{above} top of ground.
- (4) casing *2 1/2"* _(material), *284'* _(depth)
 _____ if telescope see back.
 (size)
- (5) screen *2x10* _(length), *284* _(depth to top)
2" _(size), *55* _(material)
- (6) pump *1* _(HP), *8* _(yield gpm)
E _(type power)
- (7) electric log _____

 (organization running log)
- (8) how well bottom plugged *OK*
W/line

CODED


MAY 3 - 1971

MISS. BD. OF
 WATER COM.

DRILLERS REMARKS:

If well telescopes please sketch and show depths.

GROUND LEVEL

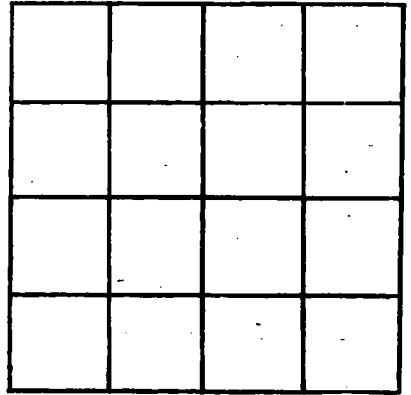

SECTION _____

Please indicate well location X.

ADDITIONAL INFORMATION

If more than one screen, show locations of each on sketch.