

HARRISON
J-135
6-6-71

MISSISSIPPI
 BOARD OF WATER COMMISSIONERS
 416 North State Street
 Jackson, Mississippi 39201

WATER WELL DRILLERS LOG

June 6 1971 Mc Hill Well Works Harrison
 date well completed firm name

CODED

LANDOWNER:	description of formations encountered	from	to
<u>Vincent Ruspali</u> <u>404 E North St.</u> <u>Pass Christian, Miss</u> (mailing address)			
	<u>sand</u>	<u>20</u>	<u>42</u>
	<u>clay</u>	<u>42</u>	<u>300</u>
	<u>slush</u>	<u>300</u>	<u>345</u>
	<u>clay</u>	<u>345</u>	<u>423</u>
	<u>sand</u>	<u>423</u>	<u>545</u>

WELL LOCATION:

sec. 39 T. 7 N. R. 13 E.
1 miles N of Delisle
 (distance) (direction) (nearest town)

WELL PURPOSE: irrigation
 (home, irrigation, municipal, industrial)

WELL COMPLETION DATA:

- (1) diameter (inches) 2"
- (2) total depth (feet) 545
- (3) static water level (feet) 26' below top of ground.
- (4) casing gal 535'
 (material) (depth)
- (size) if telescope see back.
- (5) screen 10'
 (length) (depth to top)
- 2" J.S.
 (size) (material)
- (6) pump 2 116
 (HP) (yield gpm)
- electric
 (type power)
- (7) electric log no
 (yes or no)

CODED

(organization running log)

SEP 13 1971


(8) how well bottom plugged good
shank

MISS. BD. OF
 WATER COMM.

DRILLERS REMARKS:

If well telescopes please sketch and show depths.

GROUND LEVEL

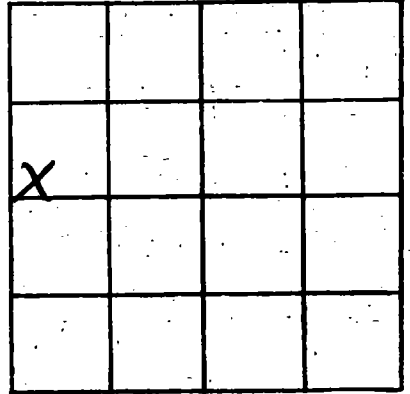

SECTION 39

Please indicate well location X.

ADDITIONAL INFORMATION

If more than one screen, show locations of each on sketch.