

HARRISON  
J 139  
10-20-71

MISSISSIPPI  
BOARD OF WATER COMMISSIONERS  
416 North State Street  
Jackson, Mississippi 39201

FEB 14 1972

WATER WELL DRILLERS LOG

MISS. BD. OF

Oct. 20 19 71 McGill well works Harrison  
date well completed firm name county well located

LANDOWNER: Lonnie McAfee

description of formations encountered

from to

Rt. 1, Box 622

Pass. Christain MS.  
(mailing address)

clay  
sand

**CODED**

0 31  
31 46

WELL LOCATION:

sec. 5 T. 7 N. R. 13 E.  
11 miles SW of Longwood  
(distance) (direction) (nearest town)

Blue clay

46 157

WELL PURPOSE: house  
(home, irrigation, municipal, industrial)

slush

157 247

WELL COMPLETION DATA:

Blue mud

247 324

(1) diameter (inches) 4 1/2"

slush

324 387

(2) total depth (feet) 400'

sand

387 410

(3) static water level (feet) 27' below above top of ground.

(4) casing gal. 400'  
(material) (depth)

(size) if telescope see back.

(5) screen 10'  
(length) (depth to top)

2" S.S.  
(size) (material)

(6) pump 1 3  
(HP) (yield gpm)

electric  
(type power)

(7) electric log no  
(yes or no)

(organization running log)


(8) how well bottom plugged sand  
shark

**CODED**

DRILLERS REMARKS:

If well telescopes please sketch and show depths.

GROUND LEVEL

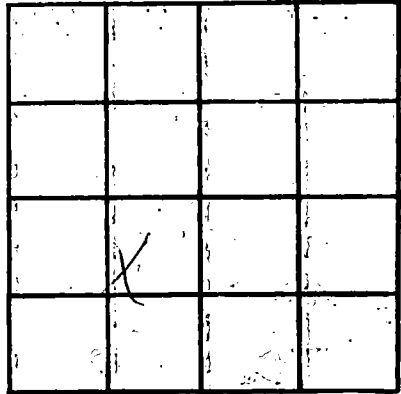

SECTION 5

Please indicate well location X.

ADDITIONAL INFORMATION

If more than one screen, show locations of each on sketch.