

HARRISON
J 143
1-25-72

MISSISSIPPI
 BOARD OF WATER COMMISSIONERS
 416 North State Street
 Jackson, Mississippi 39201

WATER WELL DRILLERS LOG

CODED

Jan 25 1972 Geneville Water Well Harrison
 (date well completed) (firm name) (county well located)

LANDOWNER Laurie Delaney
Deloit, Miss
 (mailing address)

description of formations encountered	from	to
Red clay	0	70
Red sand & gravel white	70	95
White tan Blue clay	95	210
Sand water	210	280

WELL LOCATION:
 sec 7 T 7 N R 13 E
0 miles In of Deloit
 (distance) (direction) (nearest town)

WELL PURPOSE: Home
 (home, irrigation, municipal, industrial)

WELL COMPLETION DATA:

- (1) diameter (inches) 2"
- (2) total depth (feet) 280
- (3) static water level (feet) 8 below above
 top of ground.
- (4) casing: PVC, All
(material) (depth)
 if telescope see back.
(size)
- (5) screen 10, 230
(length) (depth to top)
2", P.V.C.
(size) (material)
- (6) pump N/A, N/A
(HP) (yield gpm)
N/A
(type power)
- (7) electric log N/A
(yes or no)
N/A.
(organization running log)
- (8) how well bottom plugged Sand
Shank

CODED


MAY 25 1972

MISS. BD. OF
 WATER COMM

DRILLERS REMARKS:

If well telescopes please sketch and show depths.

GROUND LEVEL

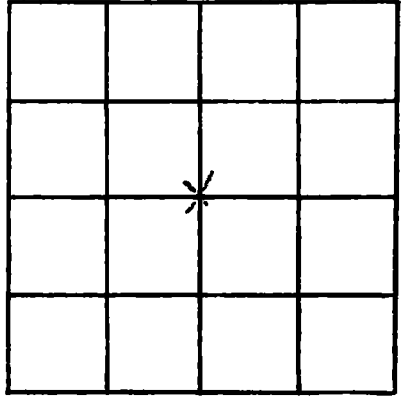

SECTION _____

Please indicate well location X.

ADDITIONAL INFORMATION

If more than one screen, show locations of each on sketch.