

HARRISON
~~J~~ J-48
 6-1-72

MISSISSIPPI
 BOARD OF WATER COMMISSIONERS
 416 North State Street
 Jackson, Mississippi 39201

WATER WELL DRILLERS LOG

CODED

JUNE 1 1972 Ladnier's Well Works HARRISON
 date well completed firm name county well located

LANDOWNER: Fred Hoffman, MD

Cable Bridge Rd.

(mailing address)

WELL LOCATION:

sec. 3 T. 7 N R. 13 E
 S W DeWitt
5 miles North of DeWitt
 (distance) (direction) (nearest town)

WELL PURPOSE: None
 (home, irrigation, municipal, industrial)

WELL COMPLETION DATA:

- (1) diameter (inches) 2 in.
- (2) total depth (feet) 420 ft.
- (3) static water level (feet) 40 below above top of ground.
- (4) casing Galv. 410 ft.
 (material) (depth)
2 in. if telescope see back.
 (size)
- (5) screen 10 ft. 410 ft.
 (length) (depth to top)
2 in. S.S.
 (size) (material)
- (6) pump 1 8
 (HP) (yield gpm)
Elect.
 (type power)
- (7) electric log NO
 (yes or no)

(organization running log)

(8) how well bottom plugged Ball Check

DRILLERS REMARKS:

description of formations encountered

from to


Red Clay	0	20
Sand & Gravel	20	164
Blue Clay	164	364
Blue Sand	364	420

CODED

JUN 11 1972

If well telescopes please sketch and show depths.

GROUND LEVEL

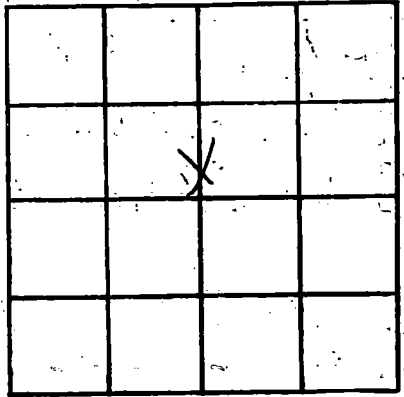

SECTION 30

Please indicate well location X.

ADDITIONAL INFORMATION

RODDED

If more than one screen, show locations of each on sketch.