

**HARRISON**  
~~J~~ 149  
 4-25-72

MISSISSIPPI  
 BOARD OF WATER COMMISSIONERS  
 416 North State Street  
 Jackson, Mississippi 39201

WATER WELL DRILLERS LOG

**CODED**

April 25, 1972 Landnier's Well Co. HARRISON  
 date well completed firm name county well located

LANDOWNER: R.E. Cofield  
Lizana Community  
 (mailing address)

description of formations encountered	from	to
<u>Red Clay</u>	<u>0</u>	<u>40</u>
<u>Sand &amp; Gravel</u>	<u>40</u>	<u>70</u>
<u>Blue Clay</u>	<u>70</u>	<u>275</u>
<u>Blue Sand</u>	<u>275</u>	<u>335</u>

WELL LOCATION:  
 sec. 3 T. 7 N R. 13 E  
                   S                  W  
2 miles North of Pass Christian  
 (distance) (direction) (nearest town)

WELL PURPOSE: HOME  
 (home, irrigation, municipal, industrial)

WELL COMPLETION DATA:

(1) diameter (inches) 2 inch

(2) total depth (feet) 335 ft.

(3) static water level (feet) 30 below above top of ground.

(4) casing Galv., 325 ft.  
 (material) (depth)  
2 in. If telescope see back.  
 (size)

(5) screen 10 ft., 325 ft.  
 (length) (depth to top)  
2 in., S.S.  
 (size) (material)

(6) pump 1 9  
 (HP) (yield gpm)  
Elect.  
 (type power)

(7) electric log No  
 (yes or no)

(organization running log)

**CODED**

JUL 11 1972

(8) how well bottom plugged Ball Check

DRILLERS REMARKS:


MISS. BU. OF  
 WATER COMMISSIONERS

If well telescopes please sketch and show depths.

GROUND LEVEL

111000

111000

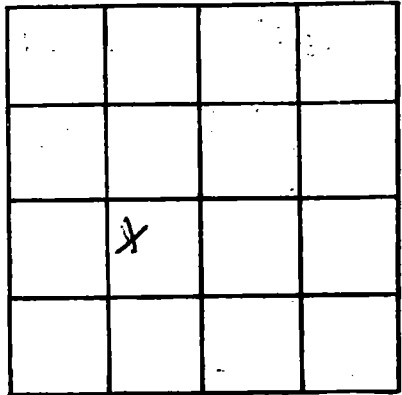

SECTION 30

Please indicate well location X.

ADDITIONAL INFORMATION

If more than one screen, show locations of each on sketch.