

**HARRISON**  
**J 154**  
**10-24-72**

MISSISSIPPI  
 BOARD OF WATER COMMISSIONERS  
 416 North State Street  
 Jackson, Mississippi 39201

**CODED**

**WATER WELL DRILLERS LOG**

date well completed Oct. 24 1972 firm name McElie Well Works county well located Harrison

LANDOWNER: Harry Adnes  
Gen. Del.  
Pass Christain, mo.  
 (mailing address)

description of formations encountered	from	to
clay	0	81
fine sand	81	112
clay	112	205
fine sand	205	246
course sand	246	294

WELL LOCATION:  
 sec. 21 T. 7 N R. 13 E  
8 1/2 miles N.W. of Delisle  
 (distance) (direction) (nearest town)

WELL PURPOSE: home  
 (home, irrigation, municipal, industrial)

- WELL COMPLETION DATA:
- (1) diameter (inches) 2"
  - (2) total depth (feet) 294'
  - (3) static water level (feet) 36' below above top of ground.
  - (4) casing gal. 284'  
 (material) (depth)  
 (size) if telescope see back.
  - (5) screen 10"  
 (length) (depth to top)  
2" plastic  
 (size) (material)
  - (6) pump 1 8  
 (HP) (yield gpm)  
electric  
 (type power)
  - (7) electric log no  
 (yes or no)

**CODED**


(organization running log)  
 (8) how well bottom plugged sand  
shark.

DRILLERS REMARKS:

10/26/72

If well telescopes please sketch and show depths.

GROUND LEVEL

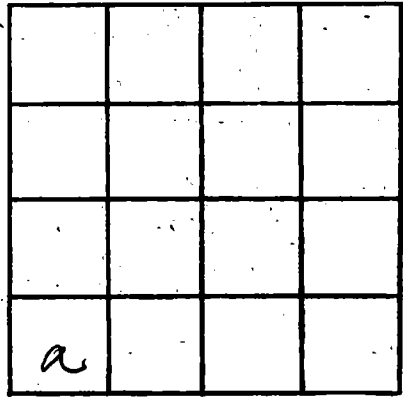

SECTION 21

Please indicate well location X.

ADDITIONAL INFORMATION

If more than one screen, show locations of each on sketch.