

HARRISON
J 155
10-27-72

MISSISSIPPI
 BOARD OF WATER COMMISSIONERS
 416 North State Street
 Jackson, Mississippi 39201

CODED

WATER WELL DRILLERS LOG

Oct. 27 1972 McGill Well Works HARRISON
 date well completed firm name county well located

LANDOWNER: Harris Ladner

Gen. Del.

Pass. Christian Miss.
 (mailing address)

WELL LOCATION:

sec. 19 T 2 N R 13 E
 S W
9 miles N.W. of Delisle
 (distance) (direction) (nearest town)

WELL PURPOSE: Home
 (home, irrigation, municipal, industrial)

WELL COMPLETION DATA:

- (1) diameter (inches) 2"
- (2) total depth (feet) 284'
- (3) static water level (feet) 27' below above top of ground.
- (4) casing gal. 274'
 (material) (depth)
 (size) If telescope see back.
- (5) screen 10' 10'
 (length) (depth to top)
2" plastic
 (size) (material)
- (6) pump 1 8
 (HP) (yield gpm)
Electric
 (type power)
- (7) electric log NO
 (yes or no)

(organization running log)

(8) how well bottom plugged Sand
SHARK

DRILLERS REMARKS:

description of formations encountered


from to

clay 0 56
course sand 56 284

CODED

If well telescopes please sketch and show depths.

GROUND LEVEL

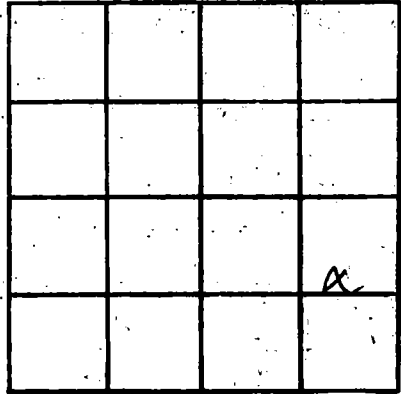

SECTION 19

Please indicate well location X.

ADDITIONAL INFORMATION

If more than one screen, show locations of each on sketch.