

HARRISON

J 156

1-10-78

MISSISSIPPI BOARD OF WATER COMMISSIONERS  
416 North State Street  
Jackson, Mississippi 39201

CODED

WATER WELL DRILLERS LOG

Jan. 10 1978 McNeil Well Works Harrison  
date well completed firm name county well located

LANDOWNER: D.V. Maram

description of formations encountered

from to

Gen. Del.

Clay

0 18

Delisle Miss.  
(mailing address)

Sand

18 60

WELL LOCATION:

sec. 8 T. 7 N R. 13 E  
8 1/2 miles N.W. of Delisle  
(distance) (direction) (nearest town)

WELL PURPOSE: Home  
(home, irrigation, municipal, industrial)

WELL COMPLETION DATA:

- (1) diameter (inches) 2"
- (2) total depth (feet) 60'
- (3) static water level (feet) 14' below top of ground.
- (4) casing 5.5 (material), 55 (depth)
- (size) if telescope see back.
- (5) screen 5' (length), (depth to top)
- 2" (size), 3.5 (material)
- (6) pump 1/2 (HP), 6 (yield gpm)
- electric (type power)
- (7) electric log NO (yes or no)
- (organization running log)
- (8) how well bottom plugged sand  
shark

CODED


DRILLERS REMARKS:

JAN 29 1978

Misc

If well telescopes please sketch and show depths.

GROUND LEVEL

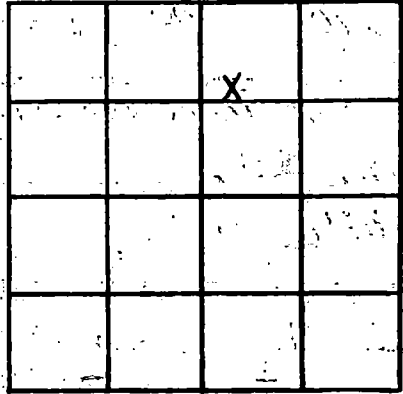

SECTION 8

Please indicate well location X.

ADDITIONAL INFORMATION

If more than one screen, show locations of each on sketch.