

HARRISON

J 157

1-6-73

MISSISSIPPI BOARD OF WATER COMMISSIONERS
416 North State Street
Jackson, Mississippi 39201

CODEN

WATER WELL DRILLERS LOG

1-6
date well completed


1973 R. J. Moore
firm name

HARRISON
county well located

LANDOWNER: <u>A. L. LADNette</u> <u>Gen. Del</u>	description of formations encountered	from	to
PASS CHRISTIAN, MISS (mailing address)	TOP SOIL	0	10
	Red CLAY SAND	10	30
	white CLAY	30	80
WELL LOCATION: sec. <u>30</u> T. <u>7</u> N. R. <u>13</u> E. <u>W</u>	Rusty SAND	80	120
<u>4</u> miles <u>N</u> of <u>PASS CHRISTIAN</u>	Blue CLAY	120	240
(distance) (direction) (nearest town)	GRAY SAND	240	272
WELL PURPOSE: (home, irrigation, municipal, industrial)			
WELL COMPLETION DATA:			
(1) diameter (inches) <u>2"</u>			
(2) total depth (feet) <u>272'</u>			
(3) static water level (feet) <u>48'</u> <u>below</u> above top of ground.			
(4) casing <u>PAW</u> <u>262'</u>			
(material) (depth)			
<u>2"</u> If telescope see back.			
(5) screen <u>2'x10'</u> <u>262'</u>			
(length) (depth to top)			
<u>2"</u> <u>SS</u>			
(size) (material)			
(6) pump <u>1</u> <u>12</u>			
(HP) (yield gpm)			
<u>F</u>			
(type power)			
(7) electric log _____			
(yes or no)			

(organization running log)			
(8) how well bottom plugged _____			
<u>By W. Thelie</u>			

DRILLERS REMARKS: _____			

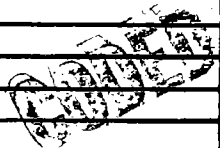


FEB 1973

WATER

If well telescopes please sketch and show depths.

GROUND LEVEL

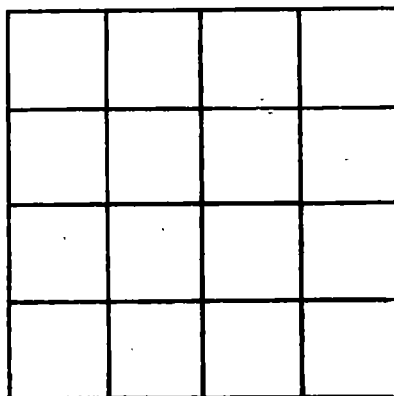

SECTION _____

Please indicate well location X.

ADDITIONAL INFORMATION

If more than one screen, show locations of each on sketch.