

HARRISON  
J 158  
2-15-72

MISSISSIPPI  
 BOARD OF WATER COMMISSIONERS  
 416 North State Street  
 Jackson, Mississippi 39201

**CODED**

**WATER WELL DRILLERS LOG**

Feb. 15 19 72 McGil well works Harrison  
 date well completed firm name county well located

LANDOWNER	description of formations encountered	from	to
<u>Edward Foye</u> <u>Re. 1, Box 161</u>			
<u>Pass Christain, Miss</u> (mailing address)	<u>clay</u>	<u>0</u>	<u>41</u>
	<u>fine sand</u>	<u>41</u>	<u>73</u>
	<u>clay</u>	<u>73</u>	<u>96</u>
	<u>lime sand</u>	<u>96</u>	<u>141</u>
	<u>clay</u>	<u>141</u>	<u>182</u>
	<u>sand</u>	<u>182</u>	<u>252</u>

WELL LOCATION:  
 sec 32 T 2 N R 13 E  
3 1/2 miles W of Dehalo  
 (distance) (direction) (nearest town)

WELL PURPOSE: Home  
 (home, irrigation, municipal, industrial)


- WELL COMPLETION DATA:
- (1) diameter (inches) 2"
  - (2) total depth (feet) 252'
  - (3) static water level (feet) 4' below above top of ground.
  - (4) casing gal. 242'  
(material) (depth)
  - if telescope see back.  
(size)
  - (5) screen 10"  
(length) (depth to top)  
2" plastic  
(size) (material)
  - (6) pump 1 8  
(HP) (yield gpm)  
electric  
(type power)
  - (7) electric log no  
(yes or no)  
                                    
(organization running log)
  - (8) how well bottom plugged sand  
shark

**CODED**

DRILLERS REMARKS:  
 \_\_\_\_\_  
 \_\_\_\_\_

If well telescopes please sketch and show depths.

GROUND LEVEL

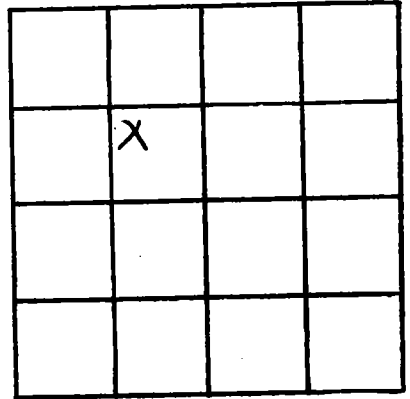

SECTION 32

Please indicate well location X.

ADDITIONAL INFORMATION

If more than one screen,  
show locations of each on sketch.