

MISSISSIPPI
BOARD OF WATER COMMISSIONERS
416 North State Street
Jackson, Mississippi 39201

CODED

WATER WELL DRILLERS LOG

HARRISON
J 161
1-27-72

Jan. 27 1972 Moyle well works Harrison
date well completed firm name county well located

LANDOWNER: Verlin Custer
Rt. 2, Box 506
Pass Christian, Miss.
(mailing address)

description of formations encountered	from to	
<u>Red clay</u>	<u>0</u>	<u>18</u>
<u>fine sand</u>	<u>18</u>	<u>42</u>
<u>coarse sand</u>	<u>42</u>	<u>68</u>

WELL LOCATION:
sec. 13 T. 7 N R. 13 E
7 1/2 miles N.E. of Delisle
(distance) (direction) (nearest town)

WELL PURPOSE: home
(home, irrigation, municipal, industrial)


- WELL COMPLETION DATA:
- (1) diameter (inches) 2"
 - (2) total depth (feet) 68'
 - (3) static water level (feet) 23' below top of ground.
 - (4) casing plastic 58'
(material) (depth)
1 (size) If telescope see back.
 - (5) screen 10' plastic
(length) (depth to top)
2" (size) (material)
 - (6) pump 1 6
(HP) (yield gpm)
electric (type power)
 - (7) electric log no
(yes or no)
 (organization running log)
 - (8) how well bottom plugged sand
shank

DRILLERS REMARKS:

MAY 29 1973

If well telescopes please sketch and show depths.

GROUND LEVEL

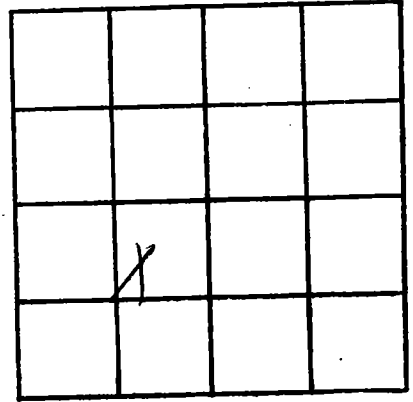

SECTION 13

Please indicate well location X.

ADDITIONAL INFORMATION

If more than one screen,
show locations of each on sketch.