

Harrison
 J 166
 1-15-73

MISSISSIPPI
 BOARD OF WATER COMMISSIONERS
 416 North State Street
 Jackson, Mississippi 39201

CODED

WATER WELL DRILLERS LOG

Jan. 15 1973 McCall Well Works Harrison
 date well completed firm name county well located

LANDOWNER: Betty Dean Deary
Miss. Del.
Delisle Miss
 (mailing address)

WELL LOCATION:
 sec. 39 T. 7 N. R. 13 E.
1 miles NE of Delisle
 (distance) (direction) (nearest town)

WELL PURPOSE: Home
 (home, irrigation, municipal, industrial)

- WELL COMPLETION DATA:
- (1) diameter (inches) 2"
 - (2) total depth (feet) 273'
 - (3) static water level (feet) 28' below top of ground
 - (4) casing plastic 263'
 (material) (depth)
 (size) If telescope see back.
 - (5) screen 10'
 (length) (depth to top)
2" plastic plastic
 (size) (material)
 - (6) pump 1/2 8
 (HP) (yield gpm)
Electric
 (type power)
 - (7) electric log no
 (yes or no)
 (organization running log)
 - (8) how well bottom plugged pond
shank

description of formations encountered	from	to
<u>clay</u>	<u>0</u>	<u>20</u>
<u>sand</u>	<u>20</u>	<u>64</u>
<u>clay</u>	<u>64</u>	<u>105</u>
<u>slush</u>	<u>105</u>	<u>168</u>
<u>clay</u>	<u>168</u>	<u>210</u>
<u>course sand</u>	<u>210</u>	<u>273</u>


CODED

DRILLERS REMARKS:

SEP 10 1973

If well telescopes please sketch and show depths.

GROUND LEVEL

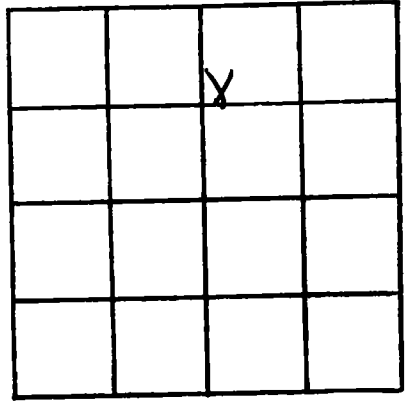

SECTION 39

Please indicate well location X.

ADDITIONAL INFORMATION

If more than one screen,
show locations of each on sketch.