

Harrison
 J167
 5-30-73

MISSISSIPPI
 BOARD OF WATER COMMISSIONERS
 416 North State Street
 Jackson, Mississippi 39201
 WATER WELL DRILLERS LOG

CODED

5/30 19 73 Sutter Well Works Harrison
 date well completed firm name county well located

| LANDOWNER: <u>Ralph McKay</u> | description of formations encountered | from | to |
|-------------------------------|---------------------------------------|------|-----|
| <u>Rt. 1 (De Lisle)</u> | | | |
| <u>Pass Christian Miss</u> | sand | 10 | 82 |
| <u>(mailing address)</u> | clay | 82 | 193 |
| | sand | 193 | 236 |

WELL LOCATION:
 sec. 39 T 7 N R 13 E
 miles in of De Lisle
 (distance) (direction) (nearest town)

WELL PURPOSE: home
 (home, irrigation, municipal, industrial)


- WELL COMPLETION DATA:
- (1) diameter (inches) 2"
 - (2) total depth (feet) 236'
 - (3) static water level (feet) 10' below surface top of ground.
 - (4) casing galv. 231'
 (material) (depth)
2" if telescope see back.
 (size)
 - (5) screen 5' 231'
 (length) (depth to top)
2" stainless steel
 (size) (material)
 - (6) pump 1/2 10
 (HP) (yield gpm)
elec.
 (type power)
 - (7) electric log no
 (yes or no)
 (organization running log)
 - (8) how well bottom plugged B.P. Valve

CODED

DRILLERS REMARKS: SEP 5 1973

If well telescopes please sketch and show depths.

GROUND LEVEL

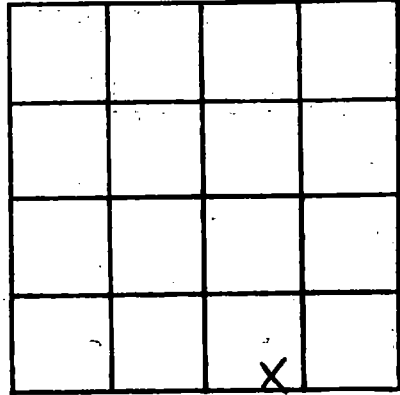

SECTION 39

Please indicate well location X.

ADDITIONAL INFORMATION

If more than one screen, show locations of each on sketch.