

HARRISON

HANCOCK

J 173

4-12-74

MISSISSIPPI BOARD OF WATER COMMISSIONERS
416 North State Street
Jackson, Mississippi 39201

CODED .

WATER WELL DRILLERS LOG Harrison

4-12-1974 date well completed
Woodwell Dr. firm name
Hancock county well located

LANDOWNER: Junia neaise
Fenton Rd
Kiln, miss
(mailing address)

description of formations encountered	from	to
<u>top Soil Clay</u>	<u>0</u>	<u>45</u>
<u>sl</u>	<u>45</u>	<u>62</u>
<u>Clay</u>	<u>62</u>	<u>220</u>
<u>sl</u>	<u>220</u>	<u>250</u>

WELL LOCATION:
sec 13 T 7 N R 13 E
13 miles N/E of Kiln
(distance) (direction) (nearest town)

WELL PURPOSE: Home
(home, irrigation, municipal, industrial)

WELL COMPLETION DATA:

- (1) diameter (inches) 2"
- (2) total depth (feet) 250'
- (3) static water level (feet) 20 ^{below} above top of ground.
- (4) casing PVC 240
(material) (depth)
1 If telescope see back.
(size)
- (5) screen 10' -
(length) (depth to top)
2" PVC-SH, 90
(size) (material)
- (6) pump - -
(HP) (yield gpm)
(type power)
- (7) electric log no
(yes or no)
N/A
(organization running log)
- (8) how well bottom plugged BWU


CODED

DRILLERS REMARKS: N/A

MISS. BOARD OF WATER COMMISSIONERS

If well telescopes please sketch and show depths.

GROUND LEVEL

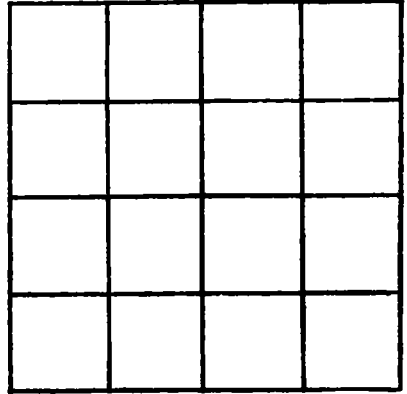

SECTION _____

Please indicate well location X.

ADDITIONAL INFORMATION

If more than one screen, show locations of each on sketch.