

J 174
 HARRISON
 5-8-73

MISSISSIPPI
 BOARD OF WATER COMMISSIONERS
 416 North State Street
 Jackson, Mississippi 39201
 WATER WELL DRILLERS LOG

May 8 19 73 Mc Gill well works, Harrison
 date well completed fish name county well located

LANDOWNER: Alton Lader

description of formations encountered	from to	
Clay	0	168
fine sand	168	197
Blue clay	197	380
20' rd. bent	380	400

Less Del.
Delisle, Mo
 (mailing/address)

WELL LOCATION:
 sec. 11 T. 7 N R. 13 E
10 miles N of Delisle
 (distance) (direction) (nearest town)

WELL PURPOSE: Home
 (home, irrigation, municipal, industrial)


- WELL COMPLETION DATA:
- (1) diameter (inches) 2"
 - (2) total depth (feet) 400'
 - (3) static water level (feet) 96' below above top of ground.
 - (4) casing gal. 390'
 (material) (depth)
 (size) If telescope see back.
 - (5) screen 10' -
 (length) (depth to top)
2" 55
 (size) (material)
 - (6) pump 1 6
 (HP) (yield gpm)
electric
 (type power)
 - (7) electric log no
 (yes or no)
 (organization running log)
 - (8) how well bottom plugged sand
mark

CODED

DRILLERS REMARKS:

If well telescopes please sketch and show depths.

GROUND LEVEL

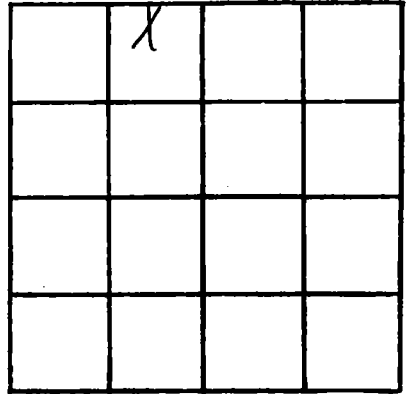

SECTION 11

Please indicate well location X.

ADDITIONAL INFORMATION

If more than one screen, show locations of each on sketch.