

J 176
HARRISON
4-26-74

MISSISSIPPI
BOARD OF WATER COMMISSIONERS
416 North State Street
Jackson, Mississippi 39201

WATER WELL DRILLERS LOG

4-26-74 19 R J Moore HARRISON
date well completed firm name county well located

LANDOWNER: J D. Mochele
Rt 3 Box 298
Gulfport
(mailing address)

description of formations encountered	from	to
TOP SOIL	0	20
Red Sand	20	25
Blue Clay	25	180
Light Sand	180	200
Blue Clay	200	480
Concrete Gravel Sand	480	536

WELL LOCATION:
sec. 1 T. 2 N. R. 13 E
13 miles NW of Gulfport
(distance) (direction) (nearest town)

WELL PURPOSE:
(Home, Irrigation, municipal, Industrial)


WELL COMPLETION DATA:
(1) diameter (inches) 2"
(2) total depth (feet) 536'
(3) static water level (feet) 38' below above top of ground
(4) casing 9" 526' (material) (depth)
(size) If telescope see back.
(5) screen 10' 526' (length) (depth to top)
2" 95 (size) (material)
(6) pump 1 12 (HP) (yield gpm)
E (type power)
(7) electric log (yes or no)
(organization running log)
(8) how well bottom plugged

CODED

DRILLERS REMARKS:

If well telescopes please sketch and show depths.

GROUND LEVEL

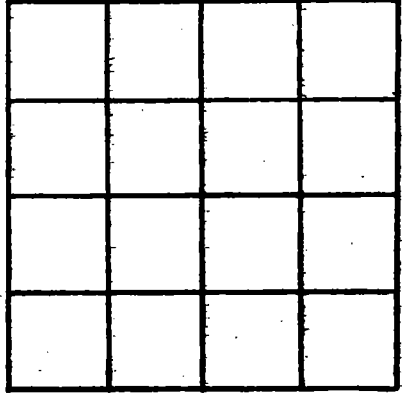

SECTION _____

Please indicate well location X.

ADDITIONAL INFORMATION

If more than one screen,
show locations of each on sketch.